

MISSISSIPPI DEPARTMENT OF NATURAL RESOURCES

Bureau of Land and Water Resources

Southport Mall

P.O. Box 10631

Jackson, Mississippi 39209

WATER WELL DRILLERS LOG

Jackson  
Q 2078  
6-24-81

6-24-81 date well completed  
Coast Water Well Sew. Inc. firm name  
Jackson county well located

LANDOWNER: Miss State Highway Dept.  
Rt 6 Box 127-A-1  
Ocean Springs, Miss.  
(mailing address) 37564

description of formations encountered	from	to
<u>R. Clay</u>	<u>0</u>	<u>15'</u>
<u>B. Clay</u>	<u>15'</u>	<u>50'</u>
<u>O. Sand</u>	<u>50'</u>	<u>73'</u>
<u>B. Clay</u>	<u>73'</u>	<u>120'</u>
<u>M. sand</u>	<u>120'</u>	<u>150'</u>


WELL LOCATION:  
sec 6 T 7 S R 4 W  
5 miles ENE of Moss Point  
(distance) (direction) (nearest town)

WELL PURPOSE: home  
(home, irrigation, municipal, industrial)

- WELL COMPLETION DATA:
- (1) diameter (inches) 2"
  - (2) total depth (feet) 150'
  - (3) static water level (feet) 5' below top of ground
  - (4) casing PVC 145'  
(material) (depth)
  - (5) screen 5 ft. 145'  
(length) (depth to top)
  - (6) pump 1 1/2 hp. 8-  
(HP) (yield gpm)  
Electric  
(type power)
  - (7) electric log No.  
(yes or no)
- (organization running log)


(8) how well bottom plugged  
Back Wash Valve

DRILLERS REMARKS:

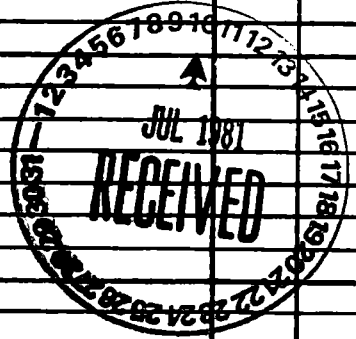

If well telescopes please sketch and show depths.

GROUND LEVEL

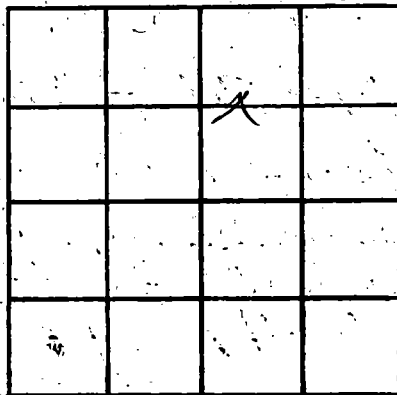

SECTION 6

Please indicate well location X.

ADDITIONAL INFORMATION

If more than one screen, show locations of each on sketch.