

MISSISSIPPI DEPARTMENT OF NATURAL RESOURCES

Bureau of Land and Water Resources

Southport Mall

P.O. Box 10631

Jackson, Mississippi 39209

WATER WELL DRILLERS LOG

JACKSON  
Q 2079  
7-10-81

July 10 1981 *Collette Drilling Co.* *Jackson*  
Date well completed firm name County well located

LANDOWNER: *Jessie Saulton*

description of formations encountered	from	to
<i>quartz clay</i>	0	15
<i>sand</i>	15	22
<i>sand</i>	22	44
<i>sand</i>	44	66
<i>sand</i>	66	88
<i>sand</i>	88	110
<i>sand</i>	110	132
<i>sand</i>	132	154
<i>clay sand</i>	154	160
<i>clay</i>	160	186
<i>clay</i>	186	198
<i>sand</i>	198	220
<i>sand</i>	220	242

*Orange Grove No. 2*  
(mailing address)

WELL LOCATION:  
sec. *22* T *7* N R. *5* E  
*4* miles *east* of *M.P.*  
(distance) (direction) (nearest town)

WELL PURPOSE: *stor*  
(home, irrigation, municipal, industrial)

WELL COMPLETION DATA:

- (1) diameter (Inches) *2"*
- (2) total depth (feet) *242*
- (3) static water level (feet) *35* <sup>below</sup> / <sub>above</sub> top of ground.
- (4) casing *plastic*, *237*  
(material) (depth)
- (size) if telescope see back.
- (5) screen *5'*, *237*  
(length) (depth to top)
- 2"*, *plastic*  
(size) (material)
- (6) pump *1*, *10*  
(HP) (yield gpm)
- elec*  
(type power)
- (7) electric log *no*  
(yes or no)

(organization running log)

(8) how well bottom plugged *BP block*

DRILLERS REMARKS:

TD


DEPT. OF NATURAL RESOURCES  
BUREAU OF LAND & WATER RESOURCES

NOV 2 1981

RECEIVED

If well telescopes please sketch and show depths.

GROUND LEVEL

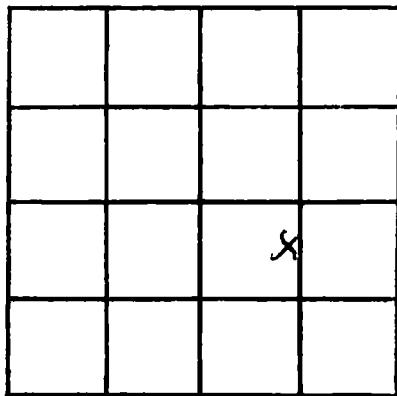

SECTION *2122*

Please indicate well location X.

ADDITIONAL INFORMATION

If more than one screen, show locations of each on sketch.