

MISSISSIPPI DEPARTMENT OF NATURAL RESOURCES

Bureau of Land and Water Resources

Southport Mall

P.O. Box 10631

Jackson, Mississippi 39209

WATER WELL DRILLERS LOG

JACKSON
Q 2081
7-21-81

7-21-81 date well completed
Coast Water Well Service, Jackson firm name
Jackson county well located

LANDOWNER: Wayne M. Hene
P.O. Box 1117
Pascagoula Miss.
(mailing address) 39367

WELL LOCATION:
sec. 26 T-7 S R-5
5 miles ENE of PASCAGOULA
(distance) (direction) (nearest town)

WELL PURPOSE: None
(home, irrigation, municipal, industrial)

WELL COMPLETION DATA:
(1) diameter (inches) 2"
(2) total depth (feet) 246'
(3) static water level (feet) 60' below
top of ground.
(4) casing PVC 236'
(material) (depth)
2" (size) if telescope see back.
(5) screen 10' 236'
(length) (depth to top)
2" (size) PVC (material)
(6) pump 1 hp. 6-
(HP) (yield gpm)
Elec. (type power)
(7) electric log No.
(yes or no)
(organization running log)

description of formations encountered	from	to
Top soil	0	3'
Red Clay	3'	8'
White Coarse sand	8'	40'
Blue Clay	40'	62'
Gray Coarse Sand	-	-
Tank gravel	62'	140'
Blue Clay	140'	200'
Gray Coarse sand	200'	246'

DEPT. OF NATURAL RESOURCES
BUREAU OF LAND & WATER RESOURCES

AUG 14 1981


RECEIVED

(8) has well bottom plugged
Back Wash Valve

DRILLERS REMARKS:

If well telescopes please sketch and show depths.

GROUND LEVEL

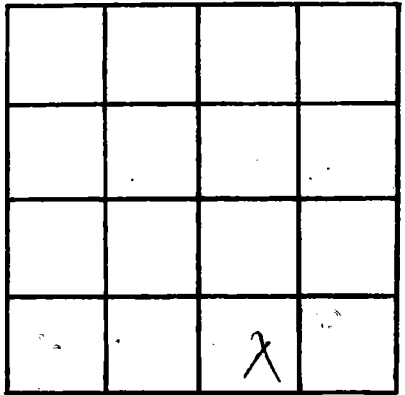

SECTION 26

Please indicate well location X.

ADDITIONAL INFORMATION

If more than one screen, show locations of each on sketch.