

MISSISSIPPI DEPARTMENT OF NATURAL RESOURCES

Bureau of Land and Water Resources

Southport Mall

P.O. Box 10631

Jackson, Mississippi 39209

WATER WELL DRILLERS LOG

JACKSON  
 Q # 19883  
 7-24-81

7-24-81 date well completed

Coast Water Well Service firm name

Jackson county/well located

Coast Water Well Service, Jackson

LANDOWNER: A. D. Indata

description of formations encountered

from

to

2911 Short Cut Rd.  
 P.O. Box 1723  
 Passapatanz, Miss.  
 (mailing address) 39567

Top soil	0	10'
C. Sand	10'	22'
B. Clay	22'	45'
M. sand	45'	60'
B. Clay	60'	82'
C. Sand	82'	110'

WELL LOCATION:

sec. 6 T. 8 S. R. 5 E. of PASSAGOOZA  
 (distance) miles (direction) (nearest town)

WELL PURPOSE: Indata  
 (home, irrigation, municipal, industrial)

WELL COMPLETION DATA:

- (1) diameter (inches) 4"
- (2) total depth (feet) 110'
- (3) static water level (feet) 20' below top of ground
- (4) casing PVC, 100' (material), (depth)
- (size) 4" if telescope see back.
- (5) screen 10' length, 100' depth to top
- (size) 4" (material) PVC
- (6) pump (HP) (yield gpm)
- (type power)
- (7) electric log No- (yes or no)

(organization running log)

(8) how well bottom plugged  
 back Wash Valve

DRILLERS REMARKS:


DEPT. OF NATURAL RESOURCES  
 BUREAU OF LAND & WATER RESOURCES

AUG 14 1981

RECEIVED

If well telescopes please sketch and show depths.

GROUND LEVEL

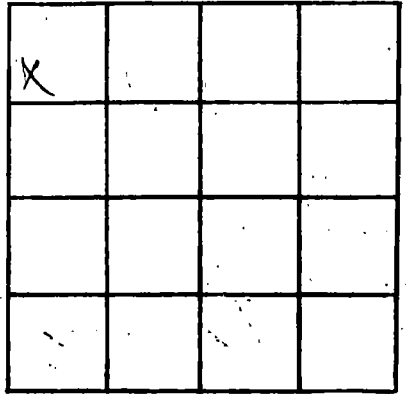

SECTION 6

Please indicate well location, X.

ADDITIONAL INFORMATION

If more than one screen,  
show locations of each on sketch.