

MISSISSIPPI DEPARTMENT OF NATURAL RESOURCES

Bureau of Land and Water Resources

Southport Mall

P.O. Box 10631

Jackson, Mississippi 39209

WATER WELL DRILLERS LOG

JACKSON
Q 2084
7-27-81

7-27-81
date well completed

81 Coast Water Well Sew. Inc. Jackson
firm name county well located

LANDOWNER: A.D. Indstr.
Electricity Co. Inc.
2911 Short Cut Rd.
Pascagoula, Miss.
(mailing address) 39567

description of formations encountered	from	to
Top Soil	0	5'
S. Clay	5'	20'
M. Sand	20'	40'
S. Clay	40'	65'
O. Sand	65'	100'

WELL LOCATION:

sec. 6 T. 8 S. R. 5 E.
IN miles (distance) of PASCAGOULA (direction) of (nearest town)

WELL PURPOSE: Indstr.
(home, irrigation, municipal, industrial)

WELL COMPLETION DATA:

- (1) diameter (inches) 4"
- (2) total depth (feet) 100'
- (3) static water level (feet) 25' below top of ground
- (4) casing PVC 85' (material) (depth)
- (5) screen 4" 15' (size) (length) 85' (depth to top)
- (6) pump (HP) (yield gpm)
- (7) electric log No. (yes or no)
- (organization running log)

(8) how well bottom plugged
Back Wash Valve

DRILLERS REMARKS:


DEPT. OF NATURAL RESOURCES
BUREAU OF LAND & WATER RESOURCES

AUG 14 1981

RECEIVED

5
If well telescopes please sketch and show depths.

GROUND LEVEL

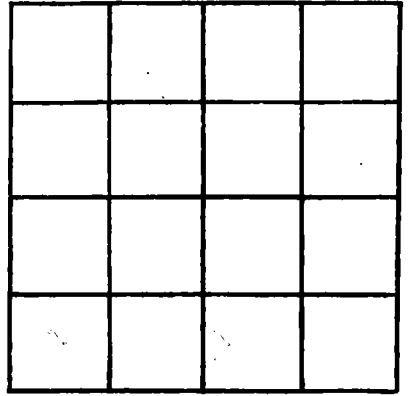

SECTION _____

Please indicate well location X.

ADDITIONAL INFORMATION

If more than one screen, show locations of each on sketch.