

MISSISSIPPI DEPARTMENT OF NATURAL RESOURCES

Bureau of Land and Water Resources

Southport Mall

P.O. Box 10631

Jackson, Mississippi 39209

WATER WELL DRILLERS LOG

JACKSON
Q 2086
10-22-81

10-22-81
date well completed

Cross Water Well Sew.
firm name

Jackson
county well located

LANDOWNER

Louis Taylor, Jr.

description of formations encountered

from

to

Rt. 1 - Box 1086
Pascagoula, Miss. 39367
(mailing address)

Top soil 0 9'

White coarse sand - E Wood 9' 88'

White coarse sand - E gravel 88' 147'

Blue clay 147' 196'

gray coarse sand 196' 280'

WELL LOCATION:

sec. 25 T. 7 S. R. 5 E. of CROSS POINT
(distance) miles (direction) of (nearest town)

WELL PURPOSE:

home (home, irrigation, municipal, industrial)

WELL COMPLETION DATA:

(1) diameter (inches) 2"
(2) total depth (feet) 280'
(3) static water level (feet) 40' below top of ground.

(4) casing PVC, 270' (material) (depth)
2" (size) If telescope see back.

(5) screen 10' 270' (length) (depth to top)
2" PVC (size) (material)

(6) pump 1/2 HP 8 (type power) (yield gpm)

(7) electric log Yes (yes or no)
(organization running log)

(8) how well bottom plugged
Back Wash Valve

DEPT. OF NATURAL RESOURCES
BUREAU OF LAND & WATER RESOURCES


NOV 18 1981

RECEIVED

DRILLERS REMARKS:

If well telescopes please sketch and show depths.

GROUND LEVEL

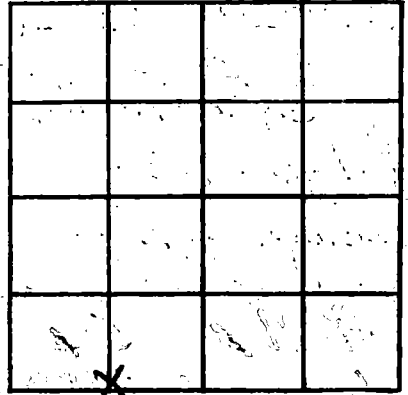

SECTION 25

Please indicate well location X.

ADDITIONAL INFORMATION

If more than one screen, show locations of each on sketch.