

MISSISSIPPI DEPARTMENT OF NATURAL RESOURCES

Bureau of Land and Water Resources

Southport Mall

P.O. Box 10631

Jackson, Mississippi 39209

WATER WELL DRILLERS LOG

Q 2088

12-28- 19 81

Coast Water Well Sew.

Jackson

date well completed

firm name

county well located

LANDOWNER:

Charles Miller

description of formations encountered

from

to

Rt. 1-Box 1099

Top soil

0 3'

Passapatanz, Miss.

(mailing address) 395-67

C. sand

3' 45'

WELL LOCATION:

sec. 36 T. 7 N. R. 5 E. S. 4 W. 4 miles E of Pass Point (distance) (direction) (nearest town)

B. Clay

45' 57'

C. sand

57' 75'

WELL PURPOSE:

(home, irrigation, municipal, industrial)

Home

B. Clay

75' 85'

C. sand

85' 147'

WELL COMPLETION DATA:

(1) diameter (inches) 2"
 (2) total depth (feet) 270'
 (3) static water level (feet) 35' below top of ground.

B. Clay

147' 197'

M. sand

197' 270'

(4) casing PVC 260'
 (material) (depth)

2" if telescope see back.
 (size)

(5) screen 10' 260'
 (length) (depth to top)

2" PVC
 (size) (material)

(6) pump 1/2 hp 10
 (HP) (yield gpm)

Elect.
 (type power)

(7) electric log No.
 (yes or no)

(organization running log)

(8) How well bottom plugged:
Back wash valve

DRILLERS REMARKS:


DEPT. OF NATURAL RESOURCES
 BUREAU OF LAND & WATER RESOURCES

JAN 26 1982

RECEIVED

If well telescopes please sketch and show depths.

GROUND LEVEL

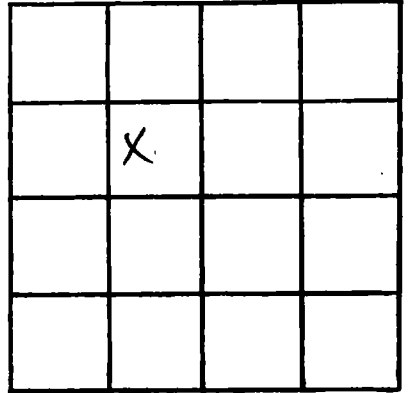

SECTION 36

Please indicate well location X.

ADDITIONAL INFORMATION

If more than one screen, show locations of each on sketch.