

MISSISSIPPI DEPARTMENT OF NATURAL RESOURCES

Bureau of Land and Water Resources

Southport Mall

P.O. Box 10631

Jackson, Mississippi 39209

WATER WELL DRILLERS LOG

Jackson
Q 2093

9-18-82 date well completed
Pierce Drilling Co firm name
Jackson county well located

LANDOWNER: Kevin Wickson
7504 Daisy Rd
Passagoula, Ms
(mailing address)

description of fomations encountered	from	to
Top Soil	0	10
Clay	10	45
Good Sand	45	55
Clay	45	135
Good Sand	135	180

WELL LOCATION:
sec. 33 T 7 N R 5 E
1 miles East of Helena
(distance) (direction) (nearest town)

WELL PURPOSE:
(home) Irrigation, municipal, industrial

WELL COMPLETION DATA:

(1) diameter (inches) 2"

(2) total depth (feet) 180'

(3) static water level (feet) 20' below above top of ground.

(4) casing Plastic, 170'
(material) (depth)

0 if telescope see back.
(size)

(5) screen 10', 180'
(length) (depth to top)

008, Plastic
(size) (material)

(6) pump 1, 12
(HP) (yield gpm)

Electric
(type power)

(7) electric log (yes or no) no

(organization running log)

(8) how well bottom plugged Bw

DEPT. OF NATURAL RESOURCES
BUREAU OF LAND & WATER RESOURCES


SEP 21 1982

RECEIVED

DRILLERS REMARKS:

If well telescopes please sketch and show depths.

GROUND LEVEL

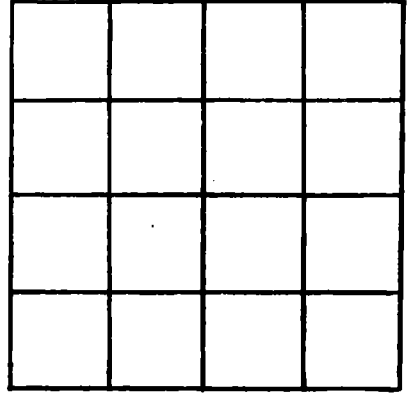

SECTION _____

Please indicate well location X.

ADDITIONAL INFORMATION

If more than one screen,
show locations of each on sketch.