

MISSISSIPPI DEPARTMENT OF NATURAL RESOURCES

Bureau of Land and Water Resources

Southport Mall

P.O. Box 10631

Jackson, Mississippi 39209

WATER WELL DRILLERS LOG

Jackson
Q 2895

11-9-
date well completed

82 Coast Water Well Sew.
firm name

Jackson
county well located

LANDOWNER: Randy L. Stork

description of formations encountered

St. 1-Sub 1076
Lascageonley Miss.
(mailing address) 39267

Top soil from 0 to 5'

C. Sand & G. from 5' 39'

WELL LOCATION:
sec. 35 T 7 N R 5 E
2 1/2 miles E of Kreske
(distance) (direction) (nearest town)

W. Clay from 39' 42'

C. Sand from 42' 75'

G. Clay from 75' 84'

WELL PURPOSE: Home
(home, irrigation, municipal, industrial)

C. Sand from 84' 143'

WELL COMPLETION DATA:

B. Clay from 143' 221'

M. Sand from 221' 270'

(1) diameter (inches) 2"

(2) total depth (feet) 270'

(3) static water level (feet) 35' below top of ground

(4) casing PVC 260' (material) (depth)

2" (size) if telescope see back.

(5) screen 10' 260' (length) (depth to top)

2" PVC (size) (material)

(6) pump 1/2 HP 7 (HP) (yield gpm)

Elect. (type power)

(7) electric log No. (yes or no)

(organization running log)

(8) how well bottom plugged back wash valve

DRILLERS REMARKS:


DEPT. OF NATURAL RESOURCES
BUREAU OF LAND & WATER RESOURCES

DEC 31 1982

RECEIVED

If well telescopes please sketch and show depths.

GROUND LEVEL

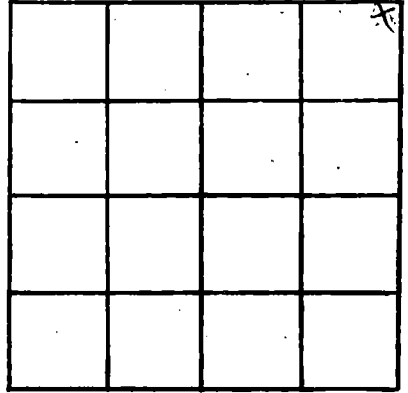

SECTION 35

Please indicate well location X.

ADDITIONAL INFORMATION

If more than one screen, show locations of each on sketch.