

MISSISSIPPI DEPARTMENT OF NATURAL RESOURCES

Bureau of Land and Water Resources

Southport Mall

P.O. Box 10631

Jackson, Mississippi 39209

WATER WELL DRILLERS LOG

*Jackson*  
*Q2096*

10-18-82 19 Coast Water Well Sew. Jackson  
date well completed firm name county well located

LANDOWNER: R. E. Poole  
Box 1 - Box 978  
Pascagoula, Miss.  
(mailing address)

description of formations encountered	from	to
Top soil	0	4'
F. Clay	4'	25'
C. Sand - G.	25'	104'
B. Clay	104'	107'
C. Sand - G.	107'	135'
B. Clay	135'	164'
C. Sand	164'	220'

WELL LOCATION:  
sec. 23 T 7 N R 5 E  
2 miles E of MOSS POINT  
(distance) (direction) (nearest town)

WELL PURPOSE: None  
(home, irrigation, municipal, industrial)

WELL COMPLETION DATA:

- (1) diameter (inches) 2"
  - (2) total depth (feet) 220'
  - (3) static water level (feet) 45' below top of ground
  - (4) casing PVC, 210'  
(material) (depth)  
2" If telescope see back.  
(size)
  - (5) screen 10', 210'  
(length) (depth to top)  
5", PVC  
(size) (material)
  - (6) pump 1 h.p., 10  
(HP) (yield gpm)  
Elect.  
(type power)
  - (7) electric log No  
(yes or no)
- (organization running log)

(8) how well bottom plugged  
Back wash valve

DRILLERS REMARKS:


DEPT. OF NATURAL RESOURCES  
BUREAU OF LAND & WATER RESOURCES

NOV 18 1982

RECEIVED

If well telescopes please sketch and show depths.

GROUND LEVEL

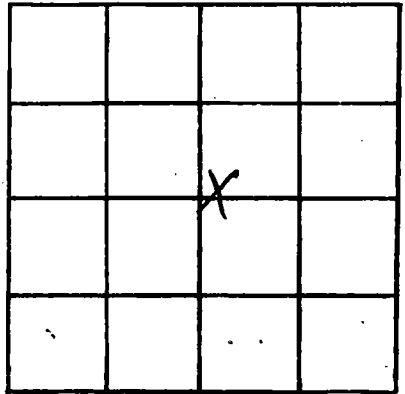

SECTION 23

Please indicate well location X.

ADDITIONAL INFORMATION

If more than one screen, show locations of each on sketch.