

MISSISSIPPI DEPARTMENT OF NATURAL RESOURCES

Bureau of Land and Water Resources

Southport Mall

P.O. Box 10631

Jackson, Mississippi 39209

WATER WELL DRILLERS LOG

Jackson  
Q 2097

3-28-83 19 Coast Water Well Sew. Jackson  
date well completed firm name county well located

LANDOWNER: Bill Perkins  
11209 Colony Lane  
Pascagoula, Miss.  
(mailing address) 37567

WELL LOCATION:  
sec. 31 T. 16 S. R. 4 E  
7 miles (distance) E (direction) of ESCATAWPA (nearest town)

WELL PURPOSE: Home  
(home, irrigation, municipal, industrial)

WELL COMPLETION DATA:

- (1) diameter (inches) 2"
- (2) total depth (feet) 150'
- (3) static water level (feet) 4' <sup>below</sup> / ~~above~~ top of ground.
- (4) casing PVC 140'  
(material) (depth)
- 2"  
(size) if telescope see back.
- (5) screen 10' 140'  
(length) (depth to top)
- 2" PVC  
(size) (material)
- (6) pump 1 1/2 HP 8  
(HP) (yield gpm)
- Elco.  
(type power)
- (7) electric log No.  
(yes or no)
- (organization running log)
- (8) how well bottom plugged back wash valve

description of formations encountered	from	to
Top soil	0	3'
Red Clay	3'	14'
Blue Clay	14'	30'
White coarse sand & gravel	30'	47'
Blue Clay	47'	110'
Gray Coarse Sand	110'	150'

DEPT. OF NATURAL RESOURCES  
BUREAU OF LAND & WATER RESOURCES


APR 28 1983

RECEIVED

DRILLERS REMARKS:

If well telescopes please sketch and show depths.

GROUND LEVEL

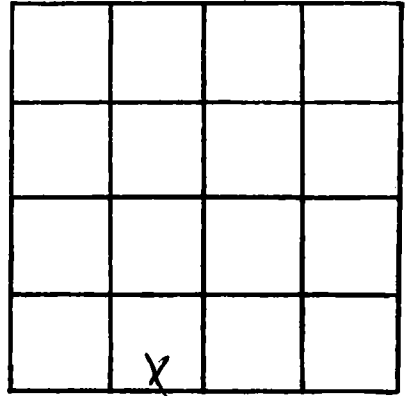

SECTION 3/

Please indicate well location X.

ADDITIONAL INFORMATION

If more than one screen,  
show locations of each on sketch.