

MISSISSIPPI DEPARTMENT OF NATURAL RESOURCES

Bureau of Land and Water Resources

Southport Mall

P.O. Box 10631

Jackson, Mississippi 39209

WATER WELL DRILLERS LOG

Jackson
Q 2098

4-18-83
date well completed

Coast Water Well Sew. Jackson
firm name county well located

LANDOWNER: Lee Watkins
9000 Meadowmoor Dr.
Pascagoula, Miss.
(mailing address) 39567

description of formations encountered	from	to
Top soil	0	2'
Red Clay	2'	10'
White Coarse sand - gravel & wood	10'	70'
Blue Clay	70'	150'
Gray Coarse sand	150'	193'
Gray Coarse sand & wood	193'	216'
Gray Coarse sand	216'	236'

WELL LOCATION:
sec 5 T 7 R 5
3 miles NE of ESCATAWIPA
(distance) (direction) (nearest town)

WELL PURPOSE: Home
(home, irrigation, municipal, industrial)

WELL COMPLETION DATA:
(1) diameter (inches) 2"
(2) total depth (feet) 236'
(3) static water level (feet) 20' (below/above top of ground)
(4) casing PVC, 226'
(material) (depth)
2" if telescope see back.
(size)
(5) screen 10', 226'
(length) (depth to top)
2", PVC
(size) (material)
(6) pump 1/2 hp., 12
(HP) (yield gpm)
Electric
(type power)
(7) electric log No.
(yes or no)
(organization running log)

(8) how well bottom plugged
backwash valve

DRILLERS REMARKS:


DEPT. OF NATURAL RESOURCES
BUREAU OF LAND & WATER RESOURCES

JUN 24 1983

RECEIVED

If well telescopes please sketch and show depths.

GROUND LEVEL

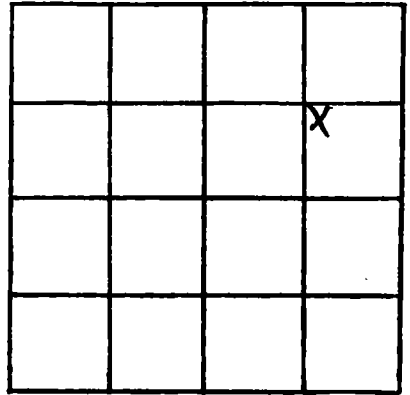

SECTION 5

Please indicate well location X.

ADDITIONAL INFORMATION

If more than one screen,
show locations of each on sketch.