

DEPT. OF NATURAL RESOURCES
BUREAU OF LAND & WATER RESOURCES

Bureau of Land and Water Resources

Southport Mall

P.O. Box 10631

Jackson, Mississippi 39209

WATER WELL DRILLERS LOG

Jackson
JUL 27 1983 2100
RECEIVED
1983

date well completed

firm name

county well located

Best Water Well Service Jackson

LANDOWNER:

Ronnie Taylor

description of formations encountered

from

to

*Rt 1 - Box 1120
Cascagoula Miss.
(mailing address)*

<i>top soil</i>	<i>0</i>	<i>3</i>
<i>red clay</i>	<i>3</i>	<i>10</i>
<i>white coarse sand</i>	<i>10</i>	<i>30</i>
<i>wh. coarse sand + wood</i>	<i>30</i>	<i>45</i>
<i>wh. coarse sand + gravel</i>	<i>45</i>	<i>50</i>
<i>blue clay</i>	<i>50</i>	<i>90</i>
<i>gray coarse sand + gravel</i>	<i>90</i>	<i>140</i>
<i>blue clay</i>	<i>140</i>	<i>200</i>
<i>gray coarse sand</i>	<i>200</i>	<i>252</i>

WELL LOCATION:

sec *26* T *7* N R *5* E
2 miles (distance) *E* (direction) of *AREOLE* (nearest town)

WELL PURPOSE:

(home, irrigation, municipal, industrial)

Residential

WELL COMPLETION DATA:

- (1) diameter (inches) *2"*
- (2) total depth (feet) *252'*
- (3) static water level (feet) *36'* ^{below} top of ground.
- (4) casing *PVC* *242'*
(material) (depth)
2" (size) if telescope see back.
- (5) screen *10'* *242'*
(length) (depth to top)
2" (size) *PVC* (material)
- (6) pump _____ (HP) _____ (yield gpm)
(type power) _____
- (7) electric log *No*
(yes or no)
(organization running log) _____


(8) how well bottom plugged *back wash valve*

DRILLERS REMARKS:

SCREENS

If well telescopes please sketch and show depths.

GROUND LEVEL

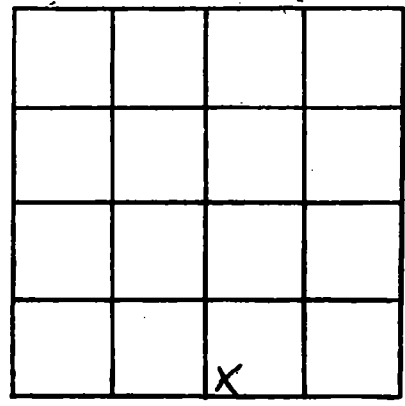

SECTION _____

Please indicate well location X.

ADDITIONAL INFORMATION

Multiple horizontal lines for writing additional information.

If more than one screen, show locations of each on sketch.