

MISSISSIPPI DEPARTMENT OF NATURAL RESOURCES

Bureau of Land and Water Resources

Southport Mall

P.O. Box 10631

Jackson, Mississippi 39209

WATER WELL DRILLERS LOG

Jackson  
Q 2101

8-18-83 19 Coast Water Well Sew. Jackson  
date well completed firm name county well located

LANDOWNER: John Boudier  
Ph K Box 990  
Pascagoula Miss  
(mailing address) 39264

WELL LOCATION:  
sec 23 T 7 N R 5 E  
IN miles (distance) (direction) of ORANGE GROVE (nearest town)

WELL PURPOSE: Home  
(home, irrigation, municipal, industrial)

- WELL COMPLETION DATA:
- (1) diameter (inches) 2"
  - (2) total depth (feet) 215'
  - (3) static water level (feet) 31' below above top of ground.
  - (4) casing PVC 205'  
(material) (depth)  
2"  
(size) If telescope see back.
  - (5) screen 10 205'  
(length) (depth to top)  
2" PVC  
(size) (material)
  - (6) pump — (HP) — (yield gpm)  
Electric  
(type power)
  - (7) electric log No.  
(yes or no)  
—  
(organization running log)
  - (8) How well bottom plugged Back road valve

description of formations encountered	from	to
<u>Top soil</u>	<u>0</u>	<u>2'</u>
<u>Red Clay</u>	<u>2'</u>	<u>10'</u>
<u>Blue Clay</u>	<u>10'</u>	<u>21'</u>
<u>White Coarse sand</u>	<u>31'</u>	<u>43'</u>
<u>White Coarse sand</u>	<u>43'</u>	<u>86'</u>
<u>White Coarse sand &amp; gravel</u>	<u>86'</u>	<u>134'</u>
<u>Blue Clay</u>	<u>134'</u>	<u>169'</u>
<u>Gray Coarse sand</u>	<u>169'</u>	<u>215'</u>


DEPT. OF NATURAL RESOURCES  
BUREAU OF LAND & WATER RESOURCES

SEP 21 1983  
RECEIVED

DRILLERS REMARKS:

If well telescopes please sketch and show depths.

GROUND LEVEL

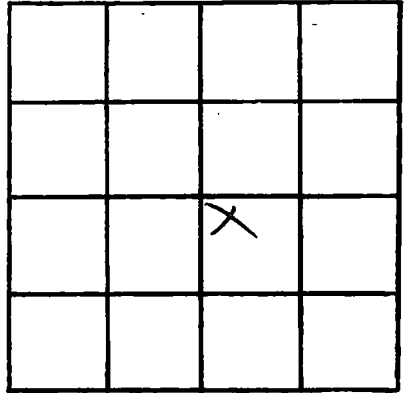

SECTION 23

Please indicate well location X.

ADDITIONAL INFORMATION

If more than one screen,  
show locations of each on sketch.