

MISSISSIPPI DEPARTMENT OF NATURAL RESOURCES

Bureau of Land and Water Resources

Southport Mall

P.O. Box 10631

Jackson, Mississippi 39209

WATER WELL DRILLERS LOG

Jackson
Q 2/05

11-8-83 19 Coast Water Well Sew. Jackson
date well completed firm name county well located

LANDOWNER: P.M. Tindell
Rt 1 Box 1100
Pascagoula Miss.
(mailing address) 39567

WELL LOCATION:
sec. 36 T. 7 S. R. 5 E
3 miles E of AREOLE
(distance) (direction) (nearest town)

WELL PURPOSE:
(home, irrigation, municipal, industrial)
Home

WELL COMPLETION DATA:

- (1) diameter (inches) 2"
- (2) total depth (feet) 263'
- (3) static water level (feet) 40' below top of ground.
- (4) casing PVC, 253'
(material) (depth)
2" If telescope see back.
(size)
- (5) screen 10', 253'
(length) (depth to top)
2", PVC
(size) (material)
- (6) pump 1/2 HP, 8 1/2
(HP) (yield gpm)
Elect.
(type power)
- (7) electric log No.
(yes or no)
(organization running log)

description of formations encountered	from	to
<u>Topsoil R. Clay</u>	<u>0</u>	<u>5'</u>
<u>A. Sand</u>	<u>5</u>	<u>40'</u>
<u>B. Clay</u>	<u>40'</u>	<u>47'</u>
<u>C. Sand & G.</u>	<u>47'</u>	<u>80'</u>
<u>B. Clay</u>	<u>80'</u>	<u>90'</u>
<u>C. Sand & G.</u>	<u>90'</u>	<u>150'</u>
<u>B. Clay</u>	<u>150'</u>	<u>205'</u>
<u>C. Sand</u>	<u>205'</u>	<u>263'</u>

(8) how well bottom plugged?
Back wash Valve

DRILLERS REMARKS:


DEPT. OF NATURAL RESOURCES
BUREAU OF LAND & WATER RESOURCES

MAR - 1 1984

RECEIVED

If well telescopes please sketch and show depths.

GROUND LEVEL

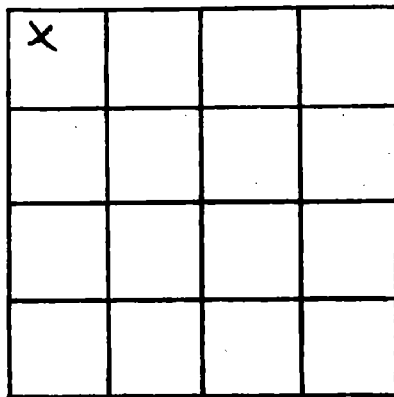

SECTION 36

Please indicate well location X.

ADDITIONAL INFORMATION

If more than one screen, show locations of each on sketch.