

MISSISSIPPI DEPARTMENT OF NATURAL RESOURCES

Bureau of Land and Water Resources

Southport Mall

P.O. Box 10631

Jackson, Mississippi 39209

WATER WELL DRILLERS LOG

Jackson  
Q2106

11-26-1983 date well completed Pierce Drilling Co. firm name Jackson county well located

LANDOWNER: Russell Seaman

description of formations encountered

from to

5704 Shingle Mill Landing

top soil

0 10

Passagoula ms  
(mailing address)

Good Sand

10 125

Clay

125 175

Good Sand

175 190

WELL LOCATION:

sec. 14 T 7 N R 5 E  
1 miles North of Orange Grove  
(distance) (direction) (nearest town)

WELL PURPOSE:

(Home, Irrigation, municipal, Industrial)

WELL COMPLETION DATA:

(1) diameter (inches) 2"  
(2) total depth (feet) 190'  
(3) static water level (feet) 20' below top of ground.

(4) casing plastic, 180' (material) (depth)  
0 If telescope see back. (size)

(5) screen 10' 190' (length) (depth to top)  
006, plastic (size) (material)

(6) pump 1 12 (HP) (yield gpm)  
Electric (type power)

(7) electric log (yes or no)  
(organization running log)

(8) how well bottom plugged BW

DEPT. OF NATURAL RESOURCES  
BUREAU OF LAND & WATER RESOURCES


FEB - 1 1984

RECEIVED

DRILLERS REMARKS:

If well telescopes please sketch and show depths.

GROUND LEVEL

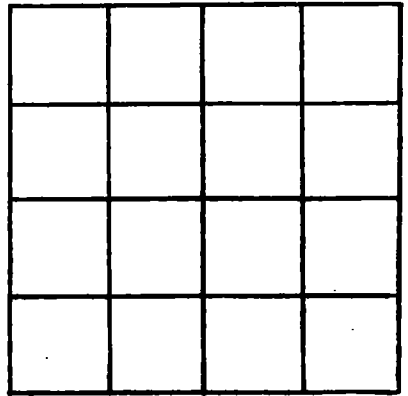

SECTION \_\_\_\_\_

Please indicate well location X.

ADDITIONAL INFORMATION

If more than one screen,  
show locations of each on sketch.