

MISSISSIPPI DEPARTMENT OF NATURAL RESOURCES

Bureau of Land and Water Resources

Southport Mall

P.O. Box 10631

Jackson, Mississippi 39209

WATER WELL DRILLERS LOG

Jackson
Q2107

12-9-83
date well completed

Coast Water Well Saw.
firm name

Jackson
county well located

LANDOWNER:

Paul M. Wright

description of formations encountered

from

to

Rt 1-Box 1282
Brazogoulay, Miss.
(mailing address) 39567

Coarse sand 0 18'

Blue Clay 18' 38'

Coarse sand 38' 92'

Blue Clay 92' 105'

Coarse sand 105' 216'

WELL LOCATION:

sec. 33 T. 7 N. R. 5 E. S. 5
1 miles (distance) S (direction) of KROLE (nearest town)

WELL PURPOSE:

(home, irrigation, municipal, industrial)
Home

Plus 10' Tail Pipe

WELL COMPLETION DATA:

- (1) diameter (inches) 2"
- (2) total depth (feet) 216'
- (3) static water level (feet) 26' below top of ground.
- (4) casing PVC 206' (material) (depth)
- 2" (size) if telescope see back.
- (5) screen 10' (length) 206' (depth to top)
- 2" (size) PVC (material)
- (6) pump 1/2 HP 7 1/2 (yield gpm)
- Electric (type power)
- (7) electric log No. (yes or no)
- (organization running log)

(8) Is well bottom plugged?
Back Wash Valve

DRILLERS REMARKS:


DEPT. OF NATURAL RESOURCES
BUREAU OF LAND & WATER RESOURCES

MAR - 1 1984

RECEIVED

If well telescopes please sketch and show depths.

GROUND LEVEL

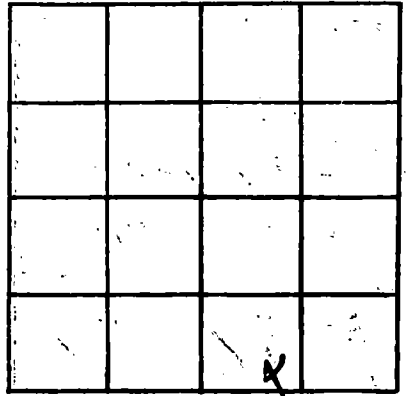

SECTION 33

Please indicate well location X.

ADDITIONAL INFORMATION

Lined area for additional information.

If more than one screen, show locations of each on sketch.