

MISSISSIPPI DEPARTMENT OF NATURAL RESOURCES

Bureau of Land and Water Resources

Southport Mall

P.O. Box 10631

Jackson, Mississippi 39209

WATER WELL DRILLERS LOG

Jackson  
Q2109

2-2-84  
date well completed

Coast Water Well Sew. Jackson  
firm name county well located

LANDOWNER:

Gene E. Jones  
Rt. 1 - Box 1070  
Pascagoula Miss.  
(mailing address) 39567

description of formations encountered

from to

WELL LOCATION:

sec 26 T 7 S R 5 W  
2 miles E of KREOLE  
(distance) (direction) (nearest town)

Top soil 0 3'  
gray clay 3 10'  
white coarse sand 10 30'  
white coarse sand & wood 30 42'  
blue clay 42 95'

WELL PURPOSE:

(home, irrigation, municipal, industrial)

home

gray coarse sand & gravel 95 140'

WELL COMPLETION DATA:

- (1) diameter (inches) 2"
- (2) total depth (feet) 248'
- (3) static water level (feet) 40' below top of ground
- (4) casing PVC 238' (material) (depth)  
2" if telescope see back. (size)
- (5) screen 10' 238' (length) (depth to top)  
2" PVC (size) (material)
- (6) pump 1hp. 12 gal. (HP) (yield gpm)
- (7) electric log No. (yes or no)

blue clay 140 197'  
blue clay & shell sand 197 211'  
gray coarse sand 211 238'  
blue clay 238 248'

DEPT. OF NATURAL RESOURCES  
BUREAU OF LAND & WATER RESOURCES

APR 30 1984

RECEIVED


(8) how well bottom plugged

back wash valve

DRILLERS REMARKS:

If well telescopes please sketch and show depths.

GROUND LEVEL

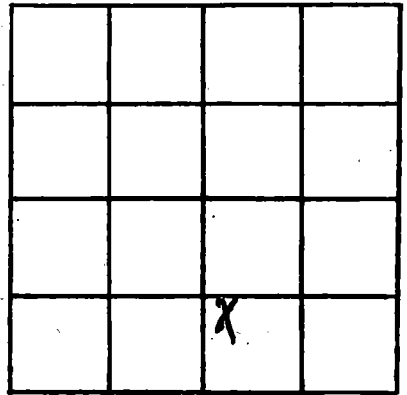

SECTION 26

Please indicate well location X.

ADDITIONAL INFORMATION

If more than one screen, show locations of ● on sketch.