

MISSISSIPPI DEPARTMENT OF NATURAL RESOURCES

Bureau of Land and Water Resources

Southport Mall

P.O. Box 10631

Jackson, Mississippi 39209

WATER WELL DRILLERS LOG

JACKSON
Q 21/10

4-2-84 date well completed
 Carl's Water Well Sew. Inc. firm name
 Jackson county well located

LANDOWNER: Saba F. Ogelsky
84 28 Joponica - Hwy
Pascagoula, Miss. 39564
 (mailing address)

WELL LOCATION:
 sec. 4 T. 7 R. 5
4 miles E of ESCAMPA
 (distance) (direction) (nearest town)

WELL PURPOSE: Home
 (home, irrigation, municipal, industrial)

WELL COMPLETION DATA:

- (1) diameter (inches) 2"
- (2) total depth (feet) 253
- (3) static water level (feet) 15' ^{below} above top of ground.
- (4) casing PVC 243'
 (material) (depth)
2" if telescope see back.
 (size)
- (5) screen 10' 243'
 (length) (depth to top)
2" PVC
 (size) (material)
- (6) pump 1 hp. 10
 (HP) (yield gpm)
Elect.
 (type power)
- (7) electric log No
 (yes or no)

(organization running log)

(8) how well bottom plugged: Back with Valve

description of formations encountered	from	to
Top soil	0'	2'
Red Clay	2'	10'
White coarse sand & gravel	10'	45'
White coarse sand & wood	45'	59'
Blue Clay	59'	150'
Blue Clay & sand	150'	169'
Blue Clay & sand	169'	216'
Gray coarse sand	216'	248'
Gray coarse sand & wood	248'	253'
10'-2" PVC Tail Pipe		

DEPT. OF NATURAL RESOURCES
 BUREAU OF LAND & WATER RESOURCES


JUL 10 1984

RECEIVED

DRILLERS REMARKS:

If well telescopes please sketch and show depths.

GROUND LEVEL

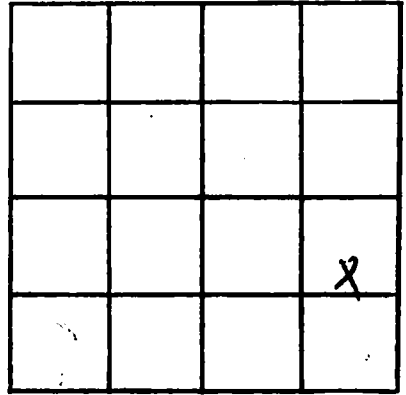

SECTION 4

Please indicate well location X.

ADDITIONAL INFORMATION

If more than one screen, show locations of each on sketch.