

MISSISSIPPI DEPARTMENT OF NATURAL RESOURCES

Bureau of Land and Water Resources

Southport Mall

P.O. Box 10631

Jackson, Mississippi 39209

WATER WELL DRILLERS LOG

Jackson
Q 2113

10-22-84 19 Cross & Water Well Dr. Jackson
date well completed firm name county well located

LANDOWNER: Phyllis L. Brown
10808 Pecan Rd
Merazoula, Miss.
(mailing address) 39567

description of formations encountered	from	to
<u>Red Clay</u>	<u>0</u>	<u>5'</u>
<u>White sand</u>	<u>5</u>	<u>85'</u>
<u>Blue Clay</u>	<u>85'</u>	<u>120'</u>
<u>White sand</u>	<u>120'</u>	<u>193'</u>
<u>5ft 2" PVC tail pipe</u>		

WELL LOCATION:
sec. 18 T. 7 S. R. 4 W.
5 miles NE of KREOLE
(distance) (direction) (nearest town)

WELL PURPOSE: Home
(home, irrigation, municipal, industrial)

WELL COMPLETION DATA:

(1) diameter (inches) 2"

(2) total depth (feet) 193

(3) static water level (feet) 64 below top of ground.

(4) casing PVC, 183'
(material) (depth)

2"
(size) If telescope see back.

(5) screen 10', 183'
(length) (depth to top)

2", PVC
(size) (material)

(6) pump _____
(HP) (yield gpm)

(type power)

(7) electric log No
(yes or no)

(organization running log)


(8) how well bottom plugged: back wash valve

DRILLERS REMARKS:

1-8-85
ZFW

If well telescopes please sketch and show depths.

GROUND LEVEL

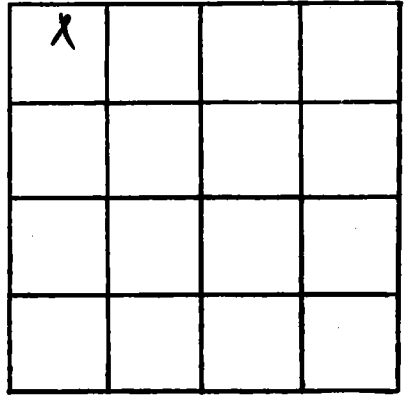

SECTION 18

Please indicate well location X.

ADDITIONAL INFORMATION

If more than one screen, show locations of each on sketch.