

MISSISSIPPI DEPARTMENT OF NATURAL RESOURCES

Bureau of Land and Water Resources

Southport Mall

P.O. Box 10631

Jackson, Mississippi 39209

WATER WELL DRILLERS LOG

JACKSON  
Q 213

7-1-85  
date well completed

19 Coast Water Well Sew.  
firm name

Jackson  
county well located

LANDOWNER:

Martin Young  
Martin Young Rd  
Pascagoula, Ms. 39567  
(mailing address)

description of formations encountered

from to

WELL LOCATION:

sec. 24 T 7 S R 5 E  
3 miles NE of KREOLE  
(distance) (direction) (nearest town)

WELL PURPOSE:

(home, irrigation, municipal, industrial)

WELL COMPLETION DATA:

- (1) diameter (inches) 2"
- (2) total depth (feet) 225'
- (3) static water level (feet) 27' below above  
top of ground.
- (4) casing PVC, 215'  
(material) (depth)  
2" if telescope see back.  
(size)
- (5) screen 10', 215'  
(length) (depth to top)  
2", PVC  
(size) (material)
- (6) pump \_\_\_\_\_  
(HP) (yield gpm)  
\_\_\_\_\_  
(type power)
- (7) electric log No  
(yes or no)  
\_\_\_\_\_  
(organization running log)
- (8) how well bottom plugged  
Back wash valve

|                               |      |      |
|-------------------------------|------|------|
| Top soil                      | 0    | 1'   |
| Red Clay                      | 1    | 10'  |
| White Coarse Sand             | 10'  | 60'  |
| White Coarse sand & Blue Clay | 60'  | 75'  |
| White Coarse sand & gravel    | 75'  | 120' |
| Blue Clay                     | 120' | 163' |
| Coarse Gray sand              | 163' | 225' |

RECEIVED


NOV - 1 1985

DRILLERS REMARKS:

Department of Natural Resources  
Bureau of Land & Water Resources

If well telescopes please sketch and show depths.

GROUND LEVEL

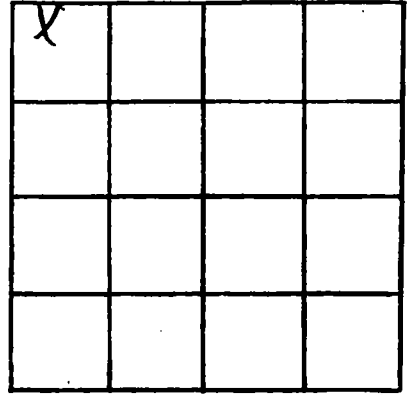

SECTION 24

Please indicate well location X.

ADDITIONAL INFORMATION

If more than one screen, show locations of each on sketch.