

MISSISSIPPI DEPARTMENT OF NATURAL RESOURCES

Bureau of Land and Water Resources

Southport Mall

P.O. Box 10631

Jackson, Mississippi 39209

WATER WELL DRILLERS LOG

JACKSON
92117

9-25-85 19
date well completed

Coast Water Well Sew. Jackson
firm name county well located

LANDOWNER: H.S. Turner

description of formations encountered from to

Bayou Cumbes.
Pascagoula Miss.
(mailing address) 95567

Top soil 0 5'

WELL LOCATION:

sec. 18 T. 8 S. R. 5 E.
IN miles (distance) of Pascagoula (direction) (nearest town)

Blue Clay 5' 15'

WELL PURPOSE: Home
(home, irrigation, municipal, industrial)

Blue Clay - Street of land 15 30'

WELL COMPLETION DATA:

(1) diameter (inches) 2"

White coarse sand 30' 50'

(2) total depth (feet) 120'

Blue Clay 50' 55'

(3) static water level (feet) 16' below top of ground

Med sand 55' 60'

(4) casing PVC 1.10' (material) (depth)

Blue Clay 60' 90'

2" (size) If telescope see back.

Med sand 55' 60'

(5) screen 5 1.10' (length) (depth to top)

Blue Clay - 2 5' Med sand

2" PVC (size) (material)


Coarse Gray sand 105' 115'

(6) pump 1/2 7 (HP) (yield gpm)

Fin gravel 115' 120'

Electric (type power)

(7) electric log No (yes or no)

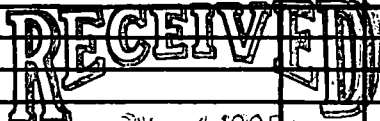

NOV = 4 1985

(organization running log)

(8) how well bottom plugged
Back Wash Valve

DRILLERS REMARKS:

5' 2" Tail Pipe

Department of Natural Resources
Bureau of Land & Water Resources

If well telescopes please sketch and show depths.

GROUND LEVEL

		X	

SECTION 18

Please indicate well location X.

ADDITIONAL INFORMATION

If more than one screen, show locations of each on sketch.