

MISSISSIPPI DEPARTMENT OF NATURAL RESOURCES

Bureau of Land and Water Resources

Southport Mall

P.O. Box 10631

Jackson, Mississippi 39209

WATER WELL DRILLERS LOG

Jackson
 () 2120

8-29-85

Coast Water well

Jackson

date well completed

firm name

county well located

LANDOWNER: Whitehead Const

description of formations encountered

from

to

5602 Industrial Rd

Top soil

0' 2'

Pas. Miss. 39567
 (mailing address)

Red fine sand

2' 6'

WELL LOCATION:

sec 32 T 7 S R 5 E
 1 N miles of Pascagoula
 (distance) (direction) (nearest town)

Blue clay

6' 41'

WELL PURPOSE: Home
 (home, irrigation, municipal, industrial)

Blue clay and oyster shell

41' 60'

WELL COMPLETION DATA:

Gray coarse sand

60' 85'

(1) diameter (inches) 2"

Gray coarse sand and wood

85' 100'

(2) total depth (feet) 280'

(3) static water level (feet) 80' below top of ground

Gray coarse sand, wood and gravel

100' 198'

(4) casing PVC, 265' CL
 (material) (depth)

Blue clay

198' 233'

2" If telescope see back.
 (size)

Gray coarse sand

233' 275'

(5) screen 10', 265'
 (length) (depth to top)

Gray coarse sand and gravel

275' 280'

2" PVC
 (size) (material)

well 275'

(6) pump (HP) (yield gpm)

(type power)

(7) electric log no (yes or no)

(organization running log)

(8) how well bottom plugged Backwash valve

DRILLERS REMARKS:

5' - 2" PVC tail pipe


RECEIVED

NOV - 4 1985

Department of Natural Resources
 Bureau of Land & Water Resources

If well telescopes please sketch and show depths.

GROUND LEVEL

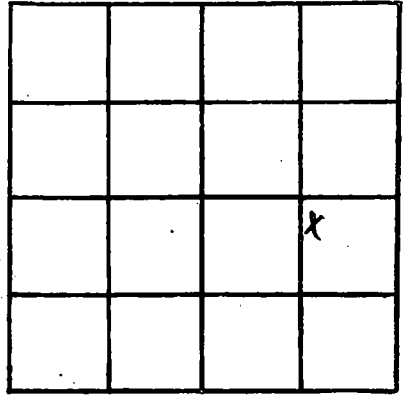

SECTION 32

Please indicate well location X.

ADDITIONAL INFORMATION

If more than one screen,
show locations of each on sketch.