

MISSISSIPPI DEPARTMENT OF NATURAL RESOURCES

Bureau of Land and Water Resources

Southport Mall

P.O. Box 10631

Jackson, Mississippi 39209

WATER WELL DRILLERS LOG

JACKSON

Q 2122

4-19
date well completed

8th Coast Water Well Serv
firm name

Jackson
county well located

LANDOWNER: Randy Busby

description of formations encountered

from to

P.O. Box 5305

Top Soil

0' 2'

Mass Point, Miss.
(mailing address) 39563

Red Clay

2' 10'

WELL LOCATION:

sec. 23 T 7 N R 5 E
2 1/2 miles NE of Kreole
(distance) (direction) (nearest town)

Gray Clay

10' 21'

White Coarse Sand

21' 60'

WELL PURPOSE:
(home, irrigation, municipal, industrial)

White Coarse Sand & Wood

60' 88'

WELL COMPLETION DATA:

White Coarse Sand & Gravel

88' 140'

(1) diameter (inches) 2"

Blue Clay

140' 160'

(2) total depth (feet) 210'

Gray Coarse Sand

160' 204'

(3) static water level (feet) 37' ^{slow} above top of ground.

Blue Clay & streak of sand

204' 210'

(4) casing P.V.C. 200'
(material) (depth)

2" (size) If telescope see back.

(10 1/2" PVC tail pipe)

(5) screen 10' 190'
(length) (depth to top)

2" (size) P.V.C. (material)

(6) pump (HP) (yield gpm)

(type power)

(7) electric log No (yes or no)

(organization running log)

(8) how well bottom plugged Backwash Valve

DRILLERS REMARKS:


DEPT. OF NATURAL RESOURCES
BUREAU OF LAND & WATER RESOURCES

JUL 10 1984

RECEIVED

If well telescopes please sketch and show depths.

GROUND LEVEL

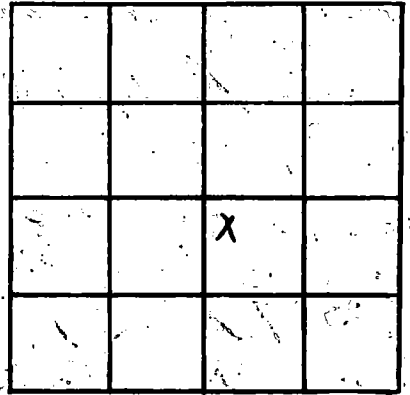

SECTION 23

Please indicate well location X.

ADDITIONAL INFORMATION

If more than one screen, show locations of each on sketch.