

MISSISSIPPI DEPARTMENT OF NATURAL RESOURCES

Bureau of Land and Water Resources

Southport Mall

P.O. Box 10631

Jackson, Mississippi 39209

WATER WELL DRILLERS LOG

JACKSON
Q2123

5-15

1984 Coast Water Well Serv.

JACKSON

date well completed

firm name

county well located

LANDOWNER: R. E. Poole

description of formations encountered

from

to

Rt 1 - Passacoula,
Miss. 39567
(mailing address)

Top Soil 0 2'

Red Clay 2' 10'

Gray Clay 10' 22'

White Coarse sand 22' 60'

White Coarse sand

gravel & wood 60' 90'

White Coarse sand & gravel 90' 134'

Blue Clay 134' 169'

Blue Clay & Strata sand 169' 191'

Gray Coarse sand 191' 215'

Blue Clay Strata sand 215' 225'

10'-2" PVC Tail Pipe Hole

WELL LOCATION:

sec. 23 T 7 N R 5 W
3 miles NE of Kreole
(distance) (direction) (nearest town)

WELL PURPOSE: Home
(home, irrigation, municipal, industrial)

WELL COMPLETION DATA:

(1) diameter (Inches) 2"

(2) total depth (feet) 225' well

(3) static water level (feet) 31' below top of ground.

(4) casing PVC 215' (material) (depth)

2" (size) If telescope see back.

(5) screen 10' 215' (length) (depth to top)

2" PVC (size) (material)

(6) pump 1/2 h.p. 6 (HP) (yield gpm)

Chlor. (type power)

(7) electric log No. (yes or no)

(organization running log)

(8) How well bottom plugged
Back Wash Valve

DRILLERS REMARKS:


DEPT. OF NATURAL RESOURCES
BUREAU OF LAND & WATER RESOURCES

MAY 10 1984

RECEIVED

If well telescopes please sketch and show depths.

GROUND LEVEL

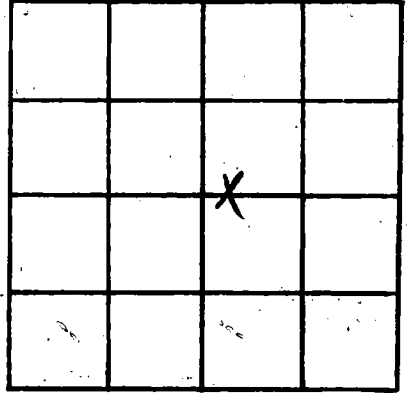

SECTION 23

Please indicate well location X.

ADDITIONAL INFORMATION

If more than one screen, show locations of each on sketch.