

MISSISSIPPI DEPARTMENT OF NATURAL RESOURCES

Bureau of Land and Water Resources

Southport Mall

P.O. Box 10631

Jackson, Mississippi 39209

WATER WELL DRILLERS LOG

JACKSON

Q 2126

6-21-84

19 Coast Water Well Sew. Jackson

date well completed

firm name

county well located

LANDOWNER

Mike Switzer
Moss Point, Miss

description of formations encountered

from

to

Red Clay	0	15'
Blue Clay	15'	28'
White Sand	28'	45'
Blue Clay	45'	110'
Sand & pea gravel	110'	150'
Blue Clay	150'	210'
Sand - white	210'	270'

(mailing address)

WELL LOCATION:

sec. 28 T. 7 S. R. 5
1/4 miles SE of Moss Point
(distance) (direction) (nearest town)

WELL PURPOSE:

(home, irrigation, municipal, industrial)

Home

WELL COMPLETION DATA:

- (1) diameter (inches) 2"
- (2) total depth (feet) well 270'
- (3) static water level (feet) 55' below top of ground.
- (4) casing PVC, 260' CL
(material) (depth)
2"
(size) if telescope see back.
- (5) screen 10', 260'
(length) (depth to top)
2" PVC
(size) (material)
- (6) pump 1hp., 8
(HP) (yield gpm)
Elect.
(type power)
- (7) electric log No.
(yes or no)
—
(organization running log)

(8) How well bottom plugged
Back wash valve

DRILLERS REMARKS:


DEPT. OF NATURAL RESOURCES
BUREAU OF LAND & WATER RESOURCES

JUL 10 1984

RECEIVED

If well telescopes please sketch and show depths.

GROUND LEVEL

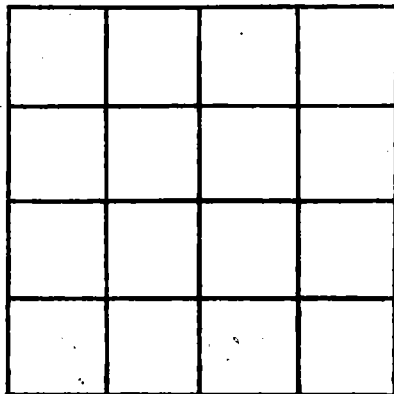

SECTION _____

Please indicate well location X.

ADDITIONAL INFORMATION

If more than one screen, show locations of each on sketch.