

MISSISSIPPI DEPARTMENT OF NATURAL RESOURCES

Bureau of Land and Water Resources

Southport Mall

P.O. Box 10631

Jackson, Mississippi 39209

WATER WELL DRILLERS LOG

Jackson
Q2128

10-2-84
date well completed

19 *Cross & Water Well Sew.*
firm name

Jackson
county well located

LANDOWNER:

Snell R. Clark

description of formations encountered

from to

Rt. 1, Box 975
Jacoby, Miss.
(mailing address) *3567*

<i>Gray Clay</i>	<i>0</i>	<i>12'</i>
<i>Gray Coarse sand</i>	<i>12'</i>	<i>110'</i>
<i>Blue Clay</i>	<i>110'</i>	<i>160'</i>
<i>Med. Sand</i>	<i>160'</i>	<i>205'</i>

WELL LOCATION:

sec *23 T 7 S R 5 E*
3 miles *NE* of *Trule*
(distance) (direction) (nearest town)

WELL PURPOSE:

(home, irrigation, municipal, industrial)

5' x 2" Tail Pipe

WELL COMPLETION DATA:

- (1) diameter (inches) *2"*
- (2) total depth (feet) *205 well*
- (3) static water level (feet) *30'* below above top of ground
- (4) casing *PVC*, *125'*, *12*
(material) (depth)
- 2"* (size) If telescope see back.
- (5) screen *10'*, *195'*
(length) (depth to top)
- 2"* (size), *PVC* (material)
- (6) pump *1* (HP), *9* (yield gpm)
- blue* (type power)
- (7) electric log *No* (yes or no)

(organization running log)


(8) How well bottom plugged
back wash valve.

1-8-85
STW

DRILLERS REMARKS:

If well telescopes please sketch and show depths.

GROUND LEVEL

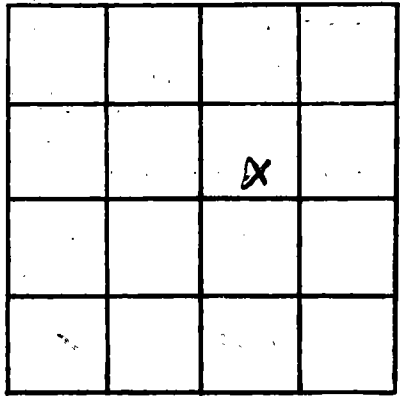

SECTION 23

Please indicate well location X.

ADDITIONAL INFORMATION

Lined area for additional information.

If more than one screen, show locations of each on sketch.