

MISSISSIPPI DEPARTMENT OF NATURAL RESOURCES

Bureau of Land and Water Resources

Southport Mall

P.O. Box 10631

Jackson, Mississippi 39209

WATER WELL DRILLERS LOG

JACKSON
Q 2133

10-11-85 date well completed
Coast Water Well Sew. firm name
Jackson county well located

LANDOWNER: West H. Stork

Pascagoula Miss.
(mailing address) 35267

WELL LOCATION:
sec 7 T 7 S R 4 W
3 1/2 miles EAST of Mass Point
(distance) (direction) (nearest town)

WELL PURPOSE: Home
(home, irrigation, municipal, industrial)

WELL COMPLETION DATA:

- (1) diameter (inches) 2"
- (2) total depth (feet) 209'
- (3) static water level (feet) 40' ^{below} _{above} top of ground.
- (4) casing PVC, 194' ^{well 204'} _{CL}
(material) (depth)
- 2" If telescope see back.
(size)
- (5) screen 10' 194'
(length) (depth to top)
- 2" PVC
(size) (material)
- (6) pump 1 h.p. 12
(HP) (yield gpm)
- Elect.
(type power)
- (7) electric log No
(yes or no)
- (organization running log)
- (8) how well bottom plugged Back Wash Valve

description of formations encountered	from	to
Top Soil	0'	2'
Red Coarse Sand	2'	25'
Blue Clay	35'	100'
Gray Coarse Sand	110'	204'
Gray Coarse Sand		
T Wood	204'	206'
Blue Clay	206'	209'
		to be


RECEIVED
NOV 26 1985

Department of Natural Resources
Bureau of Land & Water Resources

DRILLERS REMARKS:
5" Tail Pipe
Shill Catcher

If well telescopes please sketch and show depths.

GROUND LEVEL

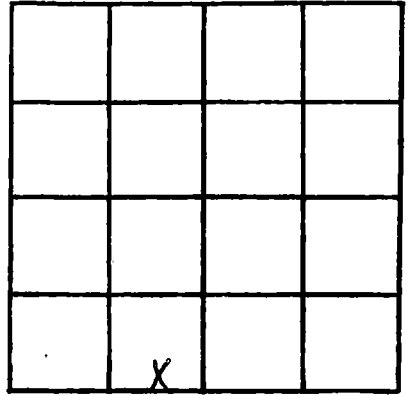

SECTION 2

Please indicate well location X.

ADDITIONAL INFORMATION

If more than one screen, show locations of each on sketch.