

MISSISSIPPI DEPARTMENT OF NATURAL RESOURCES

Bureau of Land and Water Resources

Southport Mall

P.O. Box 10631

Jackson, Mississippi 39209

WATER WELL DRILLERS LOG

Jackson  
Q 2136

12-30-85

Coastwater Well

Jackson

date well completed

firm name

county well located

LANDOWNER

Coal McCormick

Moss Point

M.S. 39523  
(mailing address)

Description of formations encountered

from

to

Top Soil	0	1
Brown Clay	1	14
White coarse sand & Gravel	14	140
Blue Clay	140	165
White coarse sand	165	220
Blue Clay	220	225
White coarse sand	225	255
Blue Clay	255	260

WELL LOCATION:

sec. 23 T. 7 N. R. 5 E.  
2 miles East of Moss Point  
(distance) (direction) (nearest town)

WELL PURPOSE: home  
(home, irrigation, municipal, industrial)

WELL COMPLETION DATA:

- (1) diameter (inches) 2"
- (2) total depth (feet) 260'
- (3) static water level (feet) 45' below top of ground
- (4) casing (material) PVC, (depth) 245' c/w 255'
- 2" (size) If telescope see back.
- (5) screen 10' (length), 245' (depth to top)
- 2" (size), PVC (material)
- (6) pump (HP) (yield gpm)
- (type power)
- (7) electric log NO (yes or no)
- (organization running log)
- (8) how well bottom plugged: Backwash valve

RECEIVED  
FEB 7 1986


Department of Natural Resources  
Bureau of Land & Water Resources

DRILLERS REMARKS:

5 ft 2" PVC  
Fair pipe

If well telescopes please sketch and show depths.

GROUND LEVEL

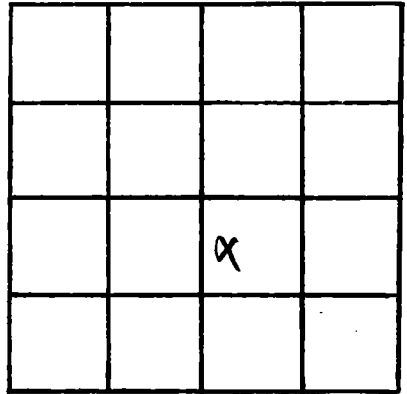

SECTION 23

Please indicate well location X.

ADDITIONAL INFORMATION

If more than one screen, show locations of each on sketch.