

MISSISSIPPI DEPARTMENT OF NATURAL RESOURCES

Bureau of Land and Water Resources

Southport Mall

P.O. Box 10631

Jackson, Mississippi 39209

WATER WELL DRILLERS LOG

Jackson
 2140

3-26-86 date well completed
 B. Poirce Drilling Co. firm name
 Jackson county well located

LANDOWNER: Peggy Sanchez
 Nut Brook Rd.
 Pascagoula Ms
 (mailing address)

description of formations encountered	from	to
2000 soil	0	15
Sand & Clay	15	30
Good Sand	30	60
Clay	60	100
Good Sand	100	140
		hole

WELL LOCATION:
 sec. 4 T. 7 N R. 5 E
 2 miles south of Helena
 (distance) (direction) (nearest town)

WELL PURPOSE:
 (home, irrigation, municipal, industrial)

WELL COMPLETION DATA:

(1) diameter (inches) 2"

(2) total depth (feet) 140'

(3) static water level (feet) 20' below above top of ground

(4) casing plastic 135' cc
 (material) (depth)

(size) If telescope see back.

(5) screen 5' 140'
 (length) (depth to top)

006 plastic
 (size) (material)

(6) pump 1 12
 (HP) (yield gpm)

electric
 (type power)

(7) electric log (yes or no)

(organization running log)

(8) how well bottom plugged Bu


RECEIVED
 MAY 14 1986

DRILLERS REMARKS:

Department of Natural Resources
 Bureau of Land & Water Resources

If well telescopes please sketch and show depths.

GROUND LEVEL

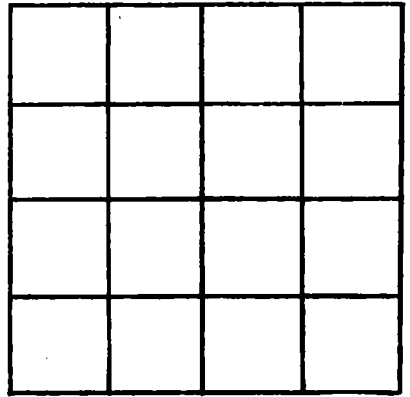

SECTION _____

Please indicate well location X.

ADDITIONAL INFORMATION

If more than one screen,
show locations of each on sketch.