

MISSISSIPPI DEPARTMENT OF NATURAL RESOURCES

Bureau of Land and Water Resources

Southport Mall

P.O. Box 10631

Jackson, Mississippi 39209

WATER WELL DRILLERS LOG

JACKSON  
 Q 2143

4/2/86  
 date well completed

So. Water well Dr  
 firm name

Jackson  
 county well located

LANDOWNER:

John Lewis  
 13024 Chatsworth  
 Rosedale Ms 39567  
 (mailing address)

description of formations encountered

from

to

0-5'	5'	15'
5-15'	15'	25'
15-25'	25'	45'
25-45'		None

WELL LOCATION:

sec. 6 T. 7 N. R. 4 E.  
 6 miles E of Rosedale  
 (distance) (direction) (nearest town)

WELL PURPOSE: Home  
 (home, irrigation, municipal, industrial)

WELL COMPLETION DATA:

- (1) diameter (inches) 2"
- (2) total depth (feet) 45' well
- (3) static water level (feet) 10' below above top of ground.
- (4) casing PVC 40' (material) (depth)  
 (size) If telescope see back.
- (5) screen 5' 40' (length) (depth to top)  
 2" PVC (size) (material)
- (6) pump 1/2 (HP) 3 1/2 (yield gpm)  
 AC (type power)
- (7) electric log NO (yes or no)  
 NO (organization running log)
- (8) how well bottom plugged

RECEIVED


APR 25 1986

DRILLERS REMARKS:

Department of Natural Resources  
 Bureau of Land & Water Resources

If well telescopes please sketch and show depths.

GROUND LEVEL

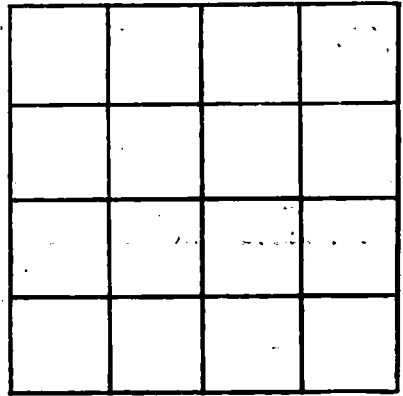

SECTION \_\_\_\_\_

Please indicate well location X.

ADDITIONAL INFORMATION

If more than one screen,  
show locations of each on sketch.