

**MISSISSIPPI DEPARTMENT OF NATURAL RESOURCES**  
**Bureau of Land and Water Resources**  
 Southport Mall  
 P.O. Box 10631  
 Jackson, Mississippi 39209  
**WATER WELL DRILLERS LOG**

Jackson  
Q 2144

5-27-86 19 Coast Water Well Jackson  
 date well completed firm name county well located

**LANDOWNER:** Robert Hasty  
PO Box 5157  
moose Point mo  
 (mailing address) 39563

**WELL LOCATION:**  
 sec. 13 T. 7 R. 5  
1 miles East of Orange Grove  
 (distance) (direction) (nearest town)

**WELL PURPOSE:** home  
 (home, irrigation, municipal, industrial)

**WELL COMPLETION DATA:**

(1) diameter (inches) 2"

(2) total depth (feet) 225'

(3) static water level (feet) 20 below top of ground.

(4) casing PVC 210' well (material) (depth) 220

2" If telescope see back. (size)

(5) screen 10' 210' (length) (depth to top)

2" (size) PVC (material)

(6) pump 1 11.5 (HP) (yield gpm)

Elect (type power)

(7) electric log no (yes or no)

(organization running log)

(8) how well bottom plugged backwash valve

description of formations encountered	from	to
top soil	0	2
Brown Clay	2	8
Blue Clay w/ streaks sand	8	33
Blue Clay	33	70
white coarse sand + gravel	70	110
Blue Clay	110	152
Gray med sand	152	180
Blue Clay	180	195
Gray med sand	195	225


**REC**  
 JUL 18 1986

Department of Natural Resources  
 Bureau of Land & Water Resources

**DRILLERS REMARKS:**  
5' - 2" PVC tailpipe

If well telescopes please sketch and show depths.

GROUND LEVEL

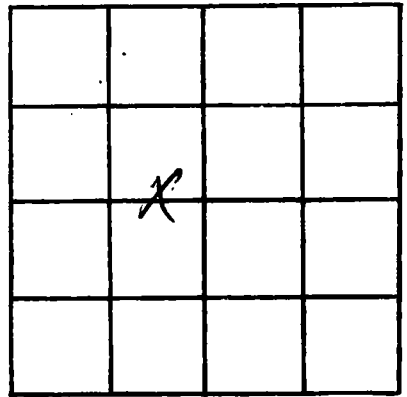

SECTION 13

Please indicate well location X.

ADDITIONAL INFORMATION

If more than one screen,  
show locations of each on sketch.