

MISSISSIPPI DEPARTMENT OF NATURAL RESOURCES

Bureau of Land and Water Resources

Southport Mall

P.O. Box 10631

Jackson, Mississippi 39209

WATER WELL DRILLERS LOG

Jackson
Q 2146

6-17-86 date well completed
Coast water well firm name
Jackson county well located

LANDOWNER:	description of formations encountered	from	to
Lakewood Cation PO BOX 5382 MOSS POINT MS (mailing address)	Top soil	0	5
WELL LOCATION: sec. <u>B T 7 N</u> R <u>5 E</u> <u>3</u> miles <u>East</u> of <u>MOSS POINT</u> (distance) (direction) (nearest town)	Red Clay	5	10
WELL PURPOSE: <u>COMMERCIAL</u> (home, irrigation, municipal, industrial)	Blue Clay	10	25
WELL COMPLETION DATA: (1) diameter (inches) <u>2"</u>	White coarse Sand + Gravel	25	175
(2) total depth (feet) <u>251'</u>	Blue Clay	175	193
(3) static water level (feet) <u>44</u> ^{below} _{above} top of ground.	Gray coarse Sand	193	210
(4) casing <u>PVC</u> , <u>237'</u> (material) (depth) <u>2"</u> (size) If telescope see back.	Gray coarse Sand + wood	210	213
(5) screen <u>9'</u> , <u>237'</u> (length) (depth to top) <u>2"</u> <u>PVC</u> (size) (material)	Blue Clay	213	237
(6) pump <u>1</u> <u>9</u> (HP) (yield gpm) <u>Elect.</u> (type power)	Gray med. Sand	237	246
(7) electric log <u>no</u> (yes or no) <u>Backwash valve</u> (organization running log)	Blue Clay	246	251
(8) <u>no</u> well bottom plugged	well 246		
DRILLERS REMARKS: <u>5' - 2" Acta pipe</u>			


RECEIVED

AUG 19 1986

Department of Natural Resources
Bureau of Land & Water Resources

If well telescopes please sketch and show depths.

GROUND LEVEL

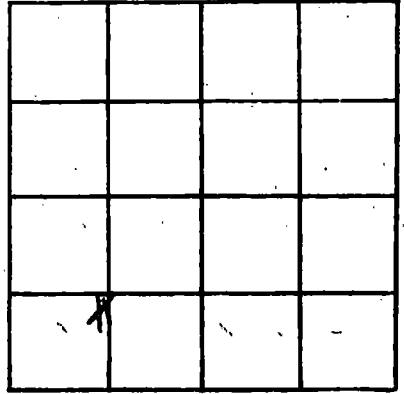

SECTION 13

Please indicate well location X.

ADDITIONAL INFORMATION

If more than one screen, show locations of each on sketch.