

MISSISSIPPI DEPARTMENT OF NATURAL RESOURCES

Bureau of Land and Water Resources

Southport Mall

P.O. Box 10631

Jackson, Mississippi 39209

WATER WELL DRILLERS LOG

Jackson
Q 2147

6-18-86 19 Coad Water Well Jackson
date well completed firm name county well located

LANDOWNER: Cm Ready

description of formations encountered

from to

10804 Pecan Rd

Pascagoula mo

(mailing address)

Top Soil

0 5

Red Clay

5 10

White Course
Sand

10 22

Blue Clay

22 46

Blue Clay
and oyster shell

46 62

White Course
Sand

62 72

Blue Clay

72 130

Blue Clay +
streak of sand

130 165

Gray Course Sand

165 191

Blue Clay

191 196

16' x 6"

WELL LOCATION:

sec. 13 T 7 N R 5 E
S W
1 N miles of Pecan
(distance) (direction) (nearest town)

WELL PURPOSE: home
(home, irrigation, municipal, industrial)

WELL COMPLETION DATA:

- (1) diameter (inches) 2"
(2) total depth (feet) 196'
(3) static water level (feet) 15' below above top of ground.
(4) casing PVC, 18 1/2' well (material) (depth) 191'
2" (size) if telescope see back.
(5) screen 10' 181' (length) (depth to top)
2" PVC (size) (material)
(6) pump 1 (HP) 14 (yield gpm)
Elect. (type power)
(7) electric log no (yes or no)

(organization running log)


(8) how well bottom plugged Backwash valve

DRILLERS REMARKS:

5ft 2" PVC
tail pipe

If well telescopes please sketch and show depths.

GROUND LEVEL

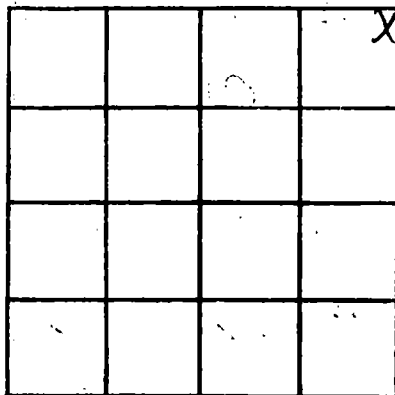

SECTION 13

Please indicate well location X.

ADDITIONAL INFORMATION

If more than one screen, show locations of each on sketch.