

MISSISSIPPI DEPARTMENT OF NATURAL RESOURCES

Bureau of Land and Water Resources

Southport Mall

P.O. Box 10631

Jackson, Mississippi 39209

WATER WELL DRILLERS LOG

Jackson  
 (S) 2448

8-21-86, 19 date well completed

Coast water well

Jackson

firm name

county well located

LANDOWNER: Redlee, Patricia  
 11000 Pean Rd  
 Pascagoula MS  
 (mailing address)

WELL LOCATION:  
 sec. 12 T. 7 N. R. 5 E. S. 1 W.  
6 1/2 miles NE of PASCAGOULA  
 (distance) (direction) (nearest town)

WELL PURPOSE: Home  
 (home, irrigation, municipal, industrial)

WELL COMPLETION DATA:  
 (1) diameter (inches) 2"  
 (2) total depth (feet) 192 ft.  
 (3) static water level (feet) 30 <sup>below</sup> <sub>above</sub> top of ground.  
 (4) casing PVC, 177ft. well 187  
 (material) (depth)  
2" If telescope see back.  
 (size)  
 (5) screen 10ft, 177ft  
 (length) (depth to top)  
2" PVC  
 (size) (material)  
 (6) pump — —  
 (HP) (yield gpm)  
 (type power)  
 (7) electric log no  
 (yes or no)  
 (organization running log)  
 (8) how well bottom plugged backwashed

Description of formations encountered	from	to
Top soil	0	5
Red clay	5	10
White coarse sand	10	22
Blue clay	22	46
Blue clay + spher shells	46	70
White coarse sand + gravel	70	86
blue clay	86	110
Blue clay + streak of sand	110	150
Gray coarse sand	150	189
Gray medium sand + wood	189	192

RECEIVED


SEP 11 1986

Department of Natural Resources  
 Bureau of Land & Water Resources

DRILLERS REMARKS:  
5ft 2" PVC tail pipe

If well telescopes please sketch and show depths.

GROUND LEVEL

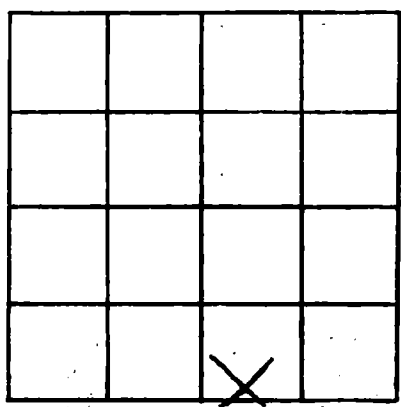

SECTION 12

Please indicate well location X.

ADDITIONAL INFORMATION

Lined area for additional information.

If more than one screen, show locations of each on sketch.