

(475-2379)

MISSISSIPPI DEPARTMENT OF NATURAL RESOURCES
Bureau of Land and Water Resources

P.O. Box 10631
Jackson, Mississippi 39209
WATER WELL DRILLERS LOG

COUNTY WELL LOCATED <i>Madison</i>	
WELL NUMBER <i>9715D</i>	CODED
DATE WELL COMPLETED <i>9-18-86</i>	

PERMIT NUMBER
NAME OF DRILLING FIRM <i>Coast Water Well Sew.</i>

NAME & MAILING ADDRESS OF LANDOWNER <i>Lempsey McSuffer</i>		
<i>5324 Burton Ave</i>		
<i>Pascagoula, MS 39567</i>		
WELL LOCATION: SEC	TOWNSHIP	RANGE
<i>23</i>	<i>7</i>	<i>5</i>
DISTANCE	DIRECTION	NEAREST TOWN
<i>IN</i> Miles	<i>W</i>	<i>Orange</i>
OTHER LANDMARK		
WELL PURPOSE: Home, Irrigation, Municipal, Industrial, Fish Pond, etc. <i>home</i>		

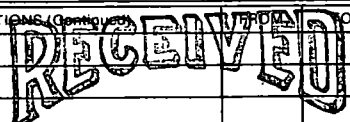
PUMP DATA		
PUMP TYPE (Circle One): Submersible, Turbine, Jet, Flowing Well, Other (Describe) _____		
POWER TYPE (Circle One): Electric, Tractor, Diesel, Gasoline, Butane, Other (Describe) _____		
Pump Capacity (GPM)	No. of Stages	Setting Depth
_____	_____	_____ FT.
PUMP TEST		
Well yielded _____ GPM with a drawdown of _____ ft. after _____ hours of pumping		

WELL DATA		
Well Depth <i>70' 5"</i>	Casing Diameter (In.) <i>2"</i>	Casing Length (Ft.) <i>60'</i>
Type of Casing <i>PVC</i>	Hole Depth <i>75'</i>	Depth to Static Water Level <i>8'</i>
TYPE OF COMPLETION: (Circle One or More): <input checked="" type="checkbox"/> Gravel Packed, <input type="checkbox"/> Underreamed, <input type="checkbox"/> Telescoped, <input checked="" type="checkbox"/> Natural Development, <input type="checkbox"/> Open Hole, <input type="checkbox"/> Other (Describe) _____		
Top of Lap Pipe or Reduction in Casing		
FEET	IF TELESKOPED OR MORE THAN ONE SCREEN: USE BACK PAGE	

LOG DATA	
TYPE OF LOG RUN (Circle One): Electric, Gamma Ray, Density, Sonic, <input checked="" type="checkbox"/> No Log Run, Neutron, Other (Describe) _____	
Name of Organization Running Log	

SCREEN DATA		
Diameter - Inches <i>2"</i>	Length - Feet <i>10'</i>	Slot Size - Inches <i>1010</i>
Screen Type <i>PVC</i>	Depth to Bottom - Feet <i>70' 6"</i>	

GEOLOGIC DATA (Office Use Only)			
Surface Elev.	Geologic Unit	Unit Thickness	Depth to Top
Subs. SWL	Date	Analysis	Aquifer Test
Driller's Remarks			

DESCRIPTION OF FORMATIONS ENCOUNTERED	FROM	TO	FORMATIONS (Continued)
<i>Top soil</i>	<i>0'</i>	<i>2'</i>	<div style="text-align: center;">  NOV 24 1986 Department of Natural Resources Bureau of Land & Water Resources </div>
<i>Red Clay</i>	<i>2'</i>	<i>10'</i>	
<i>White Coarse sand</i>	<i>10'</i>	<i>72'</i>	
<i>White Coarse sand</i>	<i>72'</i>	<i>75'</i>	
<i>Wood & gravel</i>	<i>72'</i>	<i>75'</i>	
IF MORE SPACE IS NEEDED, USE BACK			

If well telescopes please sketch and show depths.

GROUND LEVEL

X			

SECTION 23

Please indicate well location X.

ADDITIONAL INFORMATION

If more than one screen,
show location of each on sketch.