

JACKSON  
Q 2151

MISSISSIPPI  
BOARD OF WATER COMMISSIONERS  
416 North State Street  
Jackson, Mississippi 39201

WATER WELL DRILLERS LOG

7-31-1986 date well completed St. Peter Drilling Co. firm name Jackson county well located

LANDOWNER: Jean Mahathay  
5021 Trail Lane  
Pascagoula, MS  
(mailing address)

description of formations encountered	from	to
<u>Top soil</u>	<u>0</u>	<u>10</u>
<u>clay</u>	<u>10</u>	<u>20</u>
<u>sand</u>	<u>20</u>	<u>50</u>
<u>clay</u>	<u>50</u>	<u>180</u>
<u>good sand</u>	<u>180</u>	<u>240</u>
		<u>hole</u>

WELL LOCATION:  
sec. 7T 7N R. 5E  
2 miles South of Man Point  
(distance) (direction) (nearest town)

WELL PURPOSE:  
(home, irrigation, municipal, industrial)

- WELL COMPLETION DATA:
- (1) diameter (inches) 2"
  - (2) total depth (feet) 240' well
  - (3) static water level (feet) 35' <sup>below</sup> <sub>above</sub> top of ground.
  - (4) casing plastic 235cc  
(material) (depth)  
0 (size) if telescope see back.
  - (5) screen 5' 240'  
(length) (depth to top)  
006 plastic  
(size) (material)
  - (6) pump 1 8  
(HP) (yield gpm)  
electric  
(type power)
  - (7) electric log (yes or no)  
(organization running log)
  - (8) how well bottom plugged Be


RECEIVED

AUG 11 1986

DRILLERS REMARKS:

If well telescopes please sketch and show depths.

GROUND LEVEL

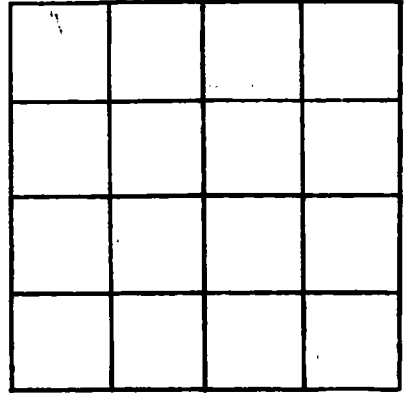

SECTION \_\_\_\_\_

Please indicate well location X.

ADDITIONAL INFORMATION

If more than one screen, show locations of each on sketch.