

MISSISSIPPI DEPARTMENT OF NATURAL RESOURCES

Bureau of Land and Water Resources

Southport Mall

P.O. Box 10631

Jackson, Mississippi 39209

WATER WELL DRILLERS LOG

JACKSON
Q 2152

10-27-1987 date well completed De Ponce Drilling Co. firm name Jackson county well located

LANDOWNER: Steve Poole
Orange Grove
Passacoula, ms
(mailing address)

description of formations encountered	from	to
top soil	0	10
clay	10	20
good sand	20	125
clay	125	200
good sand	200	235
		None

WELL LOCATION:
sec. 25 T 7 N R 5 E
1 miles south of Orange Grove
(distance) (direction) (nearest town)

WELL PURPOSE:
(home, irrigation, municipal, industrial)

- WELL COMPLETION DATA:
- (1) diameter (inches) 2"
 - (2) total depth (feet) 235' well
 - (3) static water level (feet) 30' below top of ground.
 - (4) casing plastic, 230' c
(material) (depth)
 - 0 (size) if telescope see back.
 - (5) screen 5' length, 235' depth to top
006 plastic (size) (material)
 - (6) pump 1 (HP) 10 (yield gpm)
electric (type power)
 - (7) electric log (yes or no)
 - (organization running log)
 - (8) how well bottom plugged BW

RECEIVED


SEP 15 1987

Department of Natural Resources
Bureau of Land & Water Resources

DRILLERS REMARKS:

If well telescopes please sketch and show depths.

GROUND LEVEL

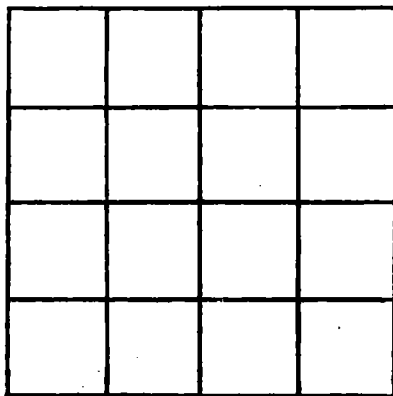

SECTION _____

Please indicate well location X.

ADDITIONAL INFORMATION

If more than one screen, show locations of each on sketch.