

**MISSISSIPPI DEPARTMENT OF NATURAL RESOURCES**  
Bureau of Land and Water Resources

P.O. Box 10631

Jackson, Mississippi 39209

**WATER WELL DRILLERS LOG**

COUNTY WELL LOCATED  
*Jackson*

WELL NUMBER CODED  
**Q 2155**

DATE WELL COMPLETED  
**6-4-87**

PERMIT NUMBER

NAME OF DRILLING FIRM  
*Coast Water Well Serv.*

NAME & MAILING ADDRESS OF LANDOWNER  
*Krentiss Floore*

*P.O. Box 5382*

*near Pent, Ms. 39563*

WELL LOCATION: SEC 23 TOWNSHIP 7<sup>N</sup> RANGE 5<sup>W</sup>

DISTANCE 1<sup>N</sup> Miles — of ORANGE

DIRECTION — NEAREST TOWN ORANGE

OTHER LANDMARK GROVE

WELL PURPOSE: Home, Irrigation, Municipal, Industrial, Fish Pond, etc.  
*home*

**PUMP DATA**

PUMP TYPE (Circle One):  
Submersible, Turbine, Jet, Flowing Well,  
Other (Describe) \_\_\_\_\_

POWER TYPE (Circle One):  
Electric, Tractor, Diesel, Gasoline, Butane,  
Other (Describe) \_\_\_\_\_

Pump Capacity (GPM) \_\_\_\_\_ No. of Stages \_\_\_\_\_ Setting Depth \_\_\_\_\_ FT.

PUMP TEST

Well yielded \_\_\_\_\_ GPM with  
a drawdown of \_\_\_\_\_ ft.  
after \_\_\_\_\_ hours of pumping

**WELL DATA**

Well Depth 230' Casing Diameter (In.) 2" Casing Length (Ft.) 220'

Type of Casing PVC Hole Depth 235' Depth to Static Water Level 35'

TYPE OF COMPLETION: (Circle One or More):  
Gravel Packed, Underreamed, Telescoped,  
Natural Development, Open Hole, Other  
(Describe) \_\_\_\_\_

Top of Lap Pipe or Reduction in Casing \_\_\_\_\_

FEET IF TELESCOPED OR MORE THAN ONE SCREEN: USE BACK PAGE

**LOG DATA**

TYPE OF LOG RUN (Circle One): No Log Run  
~~Electric~~, Gamma Ray, Density, Sonic, Neutron,  
Other (Describe) \_\_\_\_\_

Name of Organization Running Log \_\_\_\_\_

**SCREEN DATA**

Diameter - Inches 2" Length - Feet 10' Slot Size - Inches .008

Screen Type PVC Depth to Bottom - Feet 230'

**GEOLOGIC DATA (Office Use Only)**

Surface Elev.	Geologic Unit	Unit Thickness	Depth to Top
Subs. SWL	Date	Analysis	Aquifer Test

Driller's Remarks

DESCRIPTION OF FORMATIONS ENCOUNTERED	FROM	TO	FORMATIONS CONTINUED	FROM	TO
<i>Top Soil</i>	<i>0</i>	<i>2</i>			
<i>Blown Fine Sand</i>	<i>2</i>	<i>5</i>			
<i>Red &amp; White Clay</i>	<i>5</i>	<i>13</i>			
<i>Very Coarse Sand</i>	<i>13</i>	<i>90</i>			
<i>Very Coarse Sand &amp; Gravel</i>	<i>90</i>	<i>165</i>			
<i>Gravel &amp; Shredded Clay</i>	<i>165</i>	<i>195</i>			
<i>Very Coarse Sand</i>	<i>195</i>	<i>235</i>			

**RECEIVED**


SEP 21 1987

Department of Natural Resources  
Bureau of Land & Water Resources

IF MORE SPACE IS NEEDED, USE BACK

If well telescopes please sketch and show depths.

GROUND LEVEL

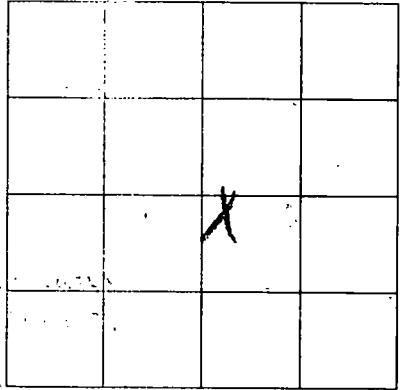


SECTION 23

Please indicate well location X.

ADDITIONAL INFORMATION

Lined area for additional information.

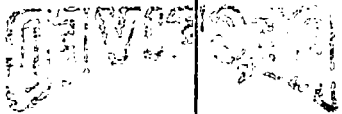

Faint text, possibly a date or reference number.

If more than one screen, show location of each on sketch.