

add loc

MISSISSIPPI DEPARTMENT OF NATURAL RESOURCES

Bureau of Land and Water Resources

COUNTY WELL LOCATED  
**Jackson**  
 WELL NUMBER CODED  
**92157**  
 DATE WELL COMPLETED  
**8-20-87**

PERMIT NUMBER  
 NAME OF DRILLING FIRM  
**Coast Water Well Svc.**

P.O. Box 10631  
 Jackson, Mississippi 39209  
 WATER WELL DRILLERS LOG

NAME & MAILING ADDRESS OF LANDOWNER  
**Greg Stringfellow**  
**11801 Pecan Rd**  
**Pascagoula MS**  
 WELL LOCATION: SEC 13 TOWNSHIP 7 1/2 N RANGE 5 E  
 DISTANCE DIRECTION NEAREST TOWN  
3 Miles E of Moss Point  
 OTHER LANDMARK  
 WELL PURPOSE: Home, Irrigation, Municipal, Industrial, Fish Pond, etc.  
home

PUMP DATA  
 PUMP TYPE (Circle One):  
 Submersible, Turbine, Jet Flowing Well,  
 Other (Describe) \_\_\_\_\_  
 POWER TYPE (Circle One):  
Electric, Tractor, Diesel, Gasoline, Butane,  
 Other (Describe) \_\_\_\_\_  
 Pump Capacity (GPM) No. of Stages Setting Depth  
14 2 — FT.  
 PUMP TEST  
 Well yielded \_\_\_\_\_ GPM with  
 a drawdown of \_\_\_\_\_ ft.  
 after \_\_\_\_\_ hours of pumping

WELL DATA  
 Well Depth 210' 15" Casing Diameter (In.) 2" Casing Length (Ft.) 195'  
 Type of Casing PVC Hole Depth 210' Depth to Static Water Level 10'  
 TYPE OF COMPLETION: (Circle One or More):  
 Gravel Packed, Natural Development, Underreamed, Telescoped,  
 Open Hole, Other  
 (Describe) \_\_\_\_\_  
 Top of Lap Pipe or Reduction in Casing  
 FEET IF TELESCOPED OR MORE THAN ONE SCREEN: USE BACK PAGE

LOG DATA  
 TYPE OF LOG RUN (Circle One):  
 Electric, Gamma Ray, Density, Sonic, No Log Run,  
 Other (Describe) \_\_\_\_\_  
 Name of Organization Running Log

SCREEN DATA  
 Diameter - Inches 2" Length - Feet 10' Slot Size - Inches .008  
 Screen Type PVC Depth to Bottom - Feet 205

GEOLOGIC DATA (Office Use Only)

|               |               |                |              |
|---------------|---------------|----------------|--------------|
| Surface Elev. | Geologic Unit | Unit Thickness | Depth to Top |
| Subs. SWL     | Date          | Analysis       | Aquifer Test |

Driller's Remarks

| DESCRIPTION OF FORMATIONS ENCOUNTERED | FROM       | TO         | FORMATION (Continued) | FROM | TO |
|---------------------------------------|------------|------------|-----------------------|------|----|
| <u>Top Sal</u>                        | <u>0</u>   | <u>2</u>   |                       |      |    |
| <u>Redup Clay</u>                     | <u>2</u>   | <u>5</u>   |                       |      |    |
| <u>White Coarse</u>                   | <u>5</u>   | <u>11</u>  |                       |      |    |
| <u>Sand</u>                           | <u>—</u>   | <u>—</u>   |                       |      |    |
| <u>Blue Clay</u>                      | <u>11</u>  | <u>55</u>  |                       |      |    |
| <u>white Coarse</u>                   | <u>55</u>  | <u>90</u>  |                       |      |    |
| <u>Sand</u>                           | <u>—</u>   | <u>—</u>   |                       |      |    |
| <u>Blue Clay</u>                      | <u>90</u>  | <u>120</u> |                       |      |    |
| <u>fine Gray Sand</u>                 | <u>20</u>  | <u>55</u>  |                       |      |    |
| <u>Blue Clay</u>                      | <u>55</u>  | <u>160</u> |                       |      |    |
| <u>Gray Coarse</u>                    | <u>160</u> | <u>210</u> |                       |      |    |
| <u>Sand</u>                           |            |            |                       |      |    |

**RECEIVED**


SEP 21 1987

Department of Natural Resources  
 Bureau of Land & Water Resources

IF MORE SPACE IS NEEDED, USE BACK

If well telescopes please sketch and show depths.

GROUND LEVEL

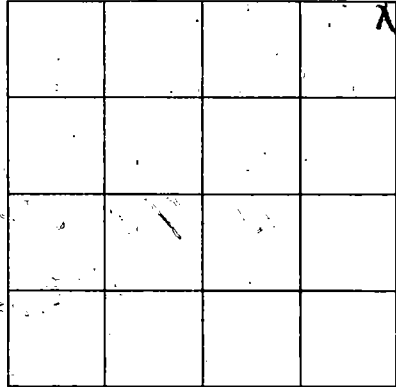

SECTION 13

Please indicate well location X.

ADDITIONAL INFORMATION

Lined area for additional information.

If more than one screen, show location of each on sketch.