

loc - purp - slot - pump
MISSISSIPPI DEPARTMENT OF NATURAL RESOURCES
 Bureau of Land and Water Resources

P.O. Box 10631
 Jackson, Mississippi 39209
WATER WELL DRILLERS LOG

COUNTY WELL LOCATED Jackson	
WELL NUMBER Q 2161	CODED
DATE WELL COMPLETED 1-28-88	

PERMIT NUMBER N/A
NAME OF DRILLING FIRM Coastwater Well Service Inc.

NAME & MAILING ADDRESS OF LANDOWNER Thiokol, Inc, PO Box 6060 Moss Point MS			
WELL LOCATION:	SEC 18	TOWNSHIP 7 S	RANGE 5 W
DISTANCE IN Miles	DIRECTION ---	NEAREST TOWN Moss Point	
OTHER LANDMARK			
WELL PURPOSE: Home, Irrigation, Municipal, <u>Industrial</u> , Fish Pond, etc. Equipment Clean up			

PUMP DATA			
PUMP TYPE (Circle One): <input checked="" type="radio"/> Submersible, Turbine, Jet, Flowing Well, Other (Describe) _____			
POWER TYPE (Circle One): <input checked="" type="radio"/> Electric, Tractor, Diesel, Gasoline, Butane, Other (Describe) _____			
Pump Capacity (GPM) 25	No. of Stages 14	Setting Depth 100 FT.	
PUMP TEST Well yielded 65 GPM with a drawdown of _____ ft. after _____ hours of pumping			

WELL DATA		
Well Depth 222'	Casing Diameter (In.) 4"	Casing Length (Ft.) 212'
Type of Casing PVC	Hole Depth 222'	Depth to Static Water Level 35'
TYPE OF COMPLETION: (Circle One or More): <input checked="" type="radio"/> Gravel Packed, Underreamed, Telescoped, <input checked="" type="radio"/> Natural Development, Open Hole, Other		
Top of Lap Pipe or Reduction in Casing FEET <input type="checkbox"/> IF TELESCOPED OR MORE THAN ONE SCREEN: USE BACK PAGE		

LOG DATA	
TYPE OF LOG RUN (Circle One): Electric, Gamma Ray, Density, Sonic, <input checked="" type="radio"/> Neutron, Other (Describe) _____	
Name of Organization Running Log	

SCREEN DATA		
Diameter - Inches 4"	Length - Feet 10'	Slot Size - Inches .008
Screen Type PVC	Depth to Bottom - Feet 222'	


GEOLOGIC DATA (Office Use Only)			
Surface Elev.	Geologic Unit	Unit Thickness	Depth to Top
Subs. SWL	Date	Analysis	Aquifer Test
Driller's Remarks			

DESCRIPTION OF FORMATIONS ENCOUNTERED	FROM	TO	FORMATIONS (Continued)	FROM	TO
Top Soil	0	2	<div style="font-size: 2em; font-weight: bold; border: 2px solid black; padding: 5px; display: inline-block;">RECEIVED</div> MAY 24 1988 Department of Natural Resources Bureau of Land & Water Resources	<div style="font-size: 2em; font-weight: bold; border: 2px solid black; padding: 5px; display: inline-block;">193</div>	
Brown Clay	2	20			
Gray Coarse sand	20	33			
Blue Clay	33	47			
Gray Coarse sand & Gravel	47	75			
Blue Clay	75	81			
Gray Coarse Sand	81	104			
Blue Clay	104	132			
Med Gray Sand	132	193			
Blue Clay	193	199			

IF MORE SPACE IS NEEDED, USE BACK

If well telescopes please sketch and show depths.

GROUND LEVEL

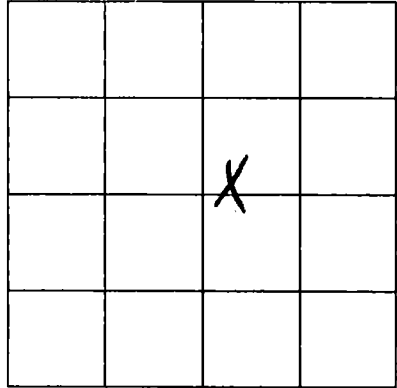

SECTION 18

Please indicate well location X.

ADDITIONAL INFORMATION

If more than one screen,
show location of each on sketch.