

**MISSISSIPPI DEPARTMENT OF NATURAL RESOURCES**  
Bureau of Land and Water Resources

P.O. Box 10631  
Jackson, Mississippi 39209  
**WATER WELL DRILLERS LOG**

COUNTY WELL LOCATED <i>Jackson</i>		PERMIT NUMBER
WELL NUMBER <i>74169</i>	CODED	NAME OF DRILLING FIRM <i>Coastwater Well Serv.</i>
DATE WELL COMPLETED <i>8-18-88</i>		

NAME & MAILING ADDRESS OF LANDOWNER <i>Richard Carroll</i>		
<i>7925 Old Stage Rd</i>		
<i>Pascagoula MS</i>		
WELL LOCATION: SEC	TOWNSHIP	RANGE
<i>27</i>	<i>7</i>	<i>5</i>
DISTANCE	DIRECTION	NEAREST TOWN
<i>1/2</i> Miles	<i>W</i>	<i>Kredle</i>
OTHER LANDMARK		
WELL PURPOSE: Home, Irrigation, Municipal, Industrial, Fish Pond, etc. <i>Home</i>		

PUMP DATA		
PUMP TYPE (Circle One): Submersible, Turbine, Jet, Flowing Well, Other (Describe)		
POWER TYPE (Circle One): Electric, Tractor, Diesel, Gasoline, Butane, Other (Describe)		
Pump Capacity (GPM)	No. of Stages	Setting Depth
		FT.
PUMP TEST		
Well yielded _____ GPM with a drawdown of _____ ft. after _____ hours of pumping		

WELL DATA		
Well Depth <i>240 3/5</i>	Casing Diameter (In.) <i>2'</i>	Casing Length (Feet) <i>225</i>
Type of Casing <i>PVC</i>	Hole Depth <i>240'</i>	Depth to Static Water Level <i>50'</i>
TYPE OF COMPLETION: (Circle One or More): Gravel Packed, Underreamed, Telescoped, Natural Development, Open Hole, Other (Describe)		
Top of Lap Pipe or Reduction in Casing		
FEET	IF TELESKOPED OR MORE THAN ONE SCREEN: USE BACK PAGE	

LOG DATA	
TYPE OF LOG RUN (Circle One): Electric, Gamma Ray, Density, Sonic, Neutron, Other (Describe)	
<i>No Log Run</i>	
Name of Organization Running Log	

SCREEN DATA		
Diameter - Inches <i>2"</i>	Length - Feet <i>10'</i>	Slot Size - Inches <i>.008</i>
Screen Type <i>PVC</i>	Depth to Bottom - Feet <i>235"</i>	

GEOLOGIC DATA (Office Use Only)			
Surface Elev.	Geologic Unit	Unit Thickness	Depth to Top
Subs. SWL	Date	Analysis	Aquifer Test

Driller's Remarks

DESCRIPTION OF FORMATIONS ENCOUNTERED	FROM	TO	FORMATION(S) (Continued)	FROM	TO
<i>Top Soil</i>	<i>0</i>	<i>2</i>			
<i>Blue Clay</i>	<i>2</i>	<i>10</i>			
<i>Med Gray Sand</i>	<i>10</i>	<i>50</i>			
<i>Blue Clay</i>	<i>50</i>	<i>70</i>			
<i>Coarse Gray Sand</i>	<i>70</i>	<i>147</i>			
<i>Blue Clay</i>	<i>147</i>	<i>174</i>			
<i>Coarse Gray Sand</i>	<i>174</i>	<i>235</i>			
<i>Blue Clay</i>	<i>235</i>	<i>240</i>			


**RECORDED**  
*NOV 15 1988*

Department of Natural Resources  
Bureau of Land & Water Resources

IF MORE SPACE IS NEEDED, USE BACK

If well telescopes please sketch and show depths.

GROUND LEVEL

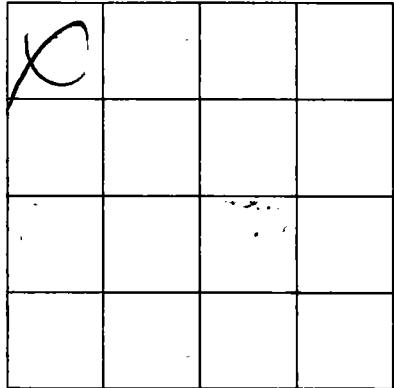

SECTION 27

Please indicate well location X.

ADDITIONAL INFORMATION

If more than one screen,  
show location of each on sketch.