

MISSISSIPPI DEPARTMENT OF NATURAL RESOURCES

Bureau of Land and Water Resources

Southport Mall

P.O. Box 10631

Jackson, Mississippi 39209

Post Office Box 185

Hurley, MS 39555

Phone 568-2474

WATER WELL DRILLERS LOG

Jackson  
Q2178

490

date well completed

Jackson  
county well located

LANDOWNER: Garland Malory  
Garland Malory

description of formations encountered

from

to

Kreale ad

sandy sil  
clay  
sand

10	20
30	45
45	65

Missouri ms  
(mailing address)

WELL LOCATION:

sec 27 T 7 N R 5 E  
City of Missouri  
(distance) (direction) (nearest town)

WELL PURPOSE:  
(home, irrigation, municipal, industrial)

WELL COMPLETION DATA:

- (1) diameter (inches) 2"
- (2) total depth (feet) 65'
- (3) static water level (feet) 12' below top of ground
- (4) casing PVC 60' (material) (depth)
- (5) screen 5' 60' (length) (depth to top)  
2" PVC (size) (material)
- (6) pump 1/2 HP 2000 gpm (HP) (yield gpm)

(type power)  
(7) electric log (yes or no)

(organization running log)

(8) how well bottom plugged BWV

DRILLERS REMARKS:


RECEIVED

AUG 29 1990

Department of Natural Resources  
Bureau of Land & Water Resources

If well telescopes please sketch and show depths.

GROUND LEVEL

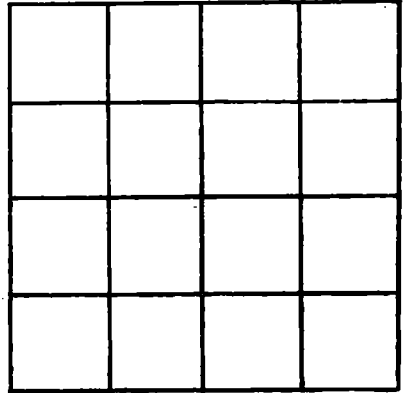

SECTION \_\_\_\_\_

Please indicate well location X.

ADDITIONAL INFORMATION

If more than one screen, show locations of each on sketch.