

**MISSISSIPPI DEPARTMENT OF NATURAL RESOURCES**  
Bureau of Land and Water Resources

P.O. Box 10631  
Jackson, Mississippi 39209  
**WATER WELL DRILLERS LOG**

COUNTY WELL LOCATED <i>Jackson</i>	
WELL NUMBER <i>Q 2171</i>	CODED
DATE WELL COMPLETED <i>5-21-90</i>	

PERMIT NUMBER
NAME OF DRILLING FIRM <i>Coast Water Well Ser.</i>

NAME & MAILING ADDRESS OF LANDOWNER <i>Kim Stevens</i>			
<i>Club Lamso Rd</i>			
<i>Pascagoula, Ms</i>			
WELL LOCATION	SEC	TOWNSHIP	RANGE
	<i>1</i>	<i>7<sup>N</sup> 5<sup>W</sup></i>	
DISTANCE	DIRECTION	NEAREST TOWN	
<i>4</i> Miles	<i>NE</i>	<i>Miss Point</i>	
OTHER LANDMARK			
WELL PURPOSE <input checked="" type="checkbox"/> Home Irrigation, Municipal, Industrial, Fish Pond, etc.			

<b>PUMP DATA</b>		
PUMP TYPE (Circle One): Submersible, Turbine, <input checked="" type="radio"/> <b>Flowing Well</b> , Other (Describe) _____		
POWER TYPE (Circle One): <input checked="" type="radio"/> <b>Electric</b> , Tractor, Diesel, Gasoline, Butane, Other (Describe) _____ H/P <i>Y2</i>		
Pump Capacity (GPM) <i>8</i>	No. of Stages <i>1</i>	Setting Depth _____ FT.
PUMP TEST		
Well yielded _____ GPM with a drawdown of _____ ft. after _____ hours of pumping		

<b>WELL DATA</b>		
Well Depth <i>155</i>	Casing Diameter (In.) <i>2"</i>	Casing Length (Ft.) <i>145</i>
Type of Casing <i>PVC</i>	Hole Depth <i>160'</i>	Depth to Static Water Level <i>6'</i>
TYPE OF COMPLETION: (Circle One or More): <input checked="" type="checkbox"/> Gravel Packed, <input type="checkbox"/> Underreamed, <input type="checkbox"/> Telescoped, <input checked="" type="checkbox"/> Natural Development, <input type="checkbox"/> Open Hole, <input type="checkbox"/> Other		
Top of Lap Pipe or Reduction in Casing _____ FEET <input type="checkbox"/> IF TELESCOPED OR MORE THAN ONE SCREEN: USE BACK PAGE		

<b>LOG DATA</b>	
TYPE OF LOG RUN (Circle One): Electric, Gamma Ray, Density, Sonic, Neutron, Other (Describe) _____ <input checked="" type="radio"/> <b>No Log Run</b>	
Name of Organization Running Log	

<b>SCREEN DATA</b>		
Diameter - Inches <i>2"</i>	Length - Feet <i>10</i>	Slot Size - Inches <i>.008</i>
Screen Type <i>PVC</i>	Depth to Bottom - Feet <i>155'</i>	


<b>GEOLOGIC DATA (Office Use Only)</b>			
Surface Elev.	Geologic Unit	Unit Thickness	Depth to Top
Subs. SWL	Date	Analysis	Aquifer Test
Driller's Remarks			

DESCRIPTION OF FORMATIONS ENCOUNTERED	FROM	TO	FORMATIONS (Continued)	FROM	TO
<i>Top Soil</i>	<i>0</i>	<i>2</i>	<div style="font-size: 2em; font-weight: bold; opacity: 0.5;">RECEIVED</div> <div style="font-size: 1.5em; font-weight: bold; margin-top: 10px;">OCT 12 1990</div> <div style="font-size: 0.8em; margin-top: 10px;">Department of Natural Resources Bureau of Land &amp; Water Resources</div>		
<i>Blue Clay</i>	<i>2</i>	<i>40</i>			
<i>Gray Crs. sand</i>	<i>40</i>	<i>50</i>			
<i>Blue Clay</i>	<i>50</i>	<i>58</i>			
<i>Gray Crs. sand</i>	<i>58</i>	<i>85</i>			
<i>Blue Clay</i>	<i>85</i>	<i>124</i>			
<i>Gray Crs. sand</i>	<i>124</i>	<i>160</i>			

IF MORE SPACE IS NEEDED, USE BACK

If well telescopes please  
sketch and show depths.

GROUND LEVEL

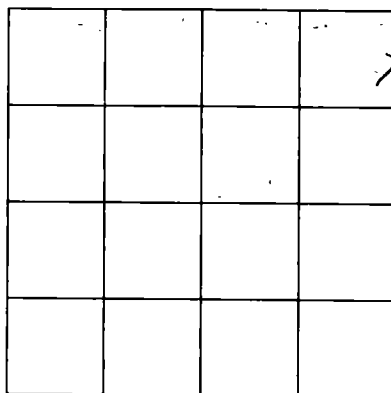

SECTION 1

Please indicate well location X.

ADDITIONAL INFORMATION

If more than one screen,  
show location of each on sketch.