

MISSISSIPPI DEPARTMENT OF NATURAL RESOURCES

Bureau of Land and Water Resources

Southport Mall

P.O. Box 10631

Jackson, Mississippi 39209

SOUTHERN WATER WELL SERVICE
Post Office Box 185

Hurley, MS 39555

Phone 589-2756
firm name

WATER WELL DRILLERS LOG

JACKSON
Q 2180

7-3-90

date well completed

19

Jackson
county well located

LANDOWNER: *Rebecca Drake et. Prerogaula*
(mailing address)

description of formations encountered
loose soil
clay
mobile clay
sand

from	to
0	15
15	35
35	55
55	75

WELL LOCATION:
sec. *8* T. *7* N. R. *5* E
City of Prerogaula
(distance) (direction) (nearest town)

WELL PURPOSE:
(home, irrigation, municipal, industrial)

WELL COMPLETION DATA:

- (1) diameter (inches) *2"*
- (2) total depth (feet) *75*
- (3) static water level (feet) *10* below above top of ground.
- (4) casing *PVC* *70*
(material) (depth)
(size) if telescope see back.
- (5) screen *5'* *70'*
(length) (depth to top)
2" *PVC*
(size) (material)
- (6) pump *1* *10*
(HP) (yield gpm)
AC
(type power)
- (7) electric log _____
(yes or no)
(organization running log)
- (8) how well bottom plugged *BWV*

RECEIVED


AUG 29 1990

Department of Natural Resources
Bureau of Land & Water Resources

DRILLERS REMARKS:

If well telescopes please sketch and show depths.

GROUND LEVEL

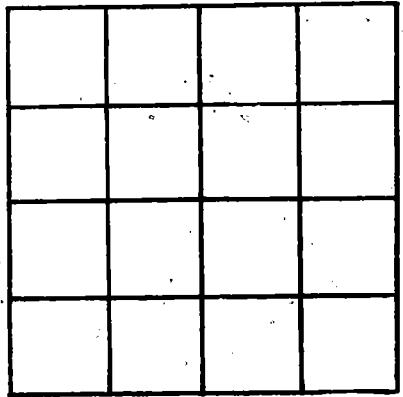

SECTION _____

Please indicate well location X.

ADDITIONAL INFORMATION

If more than one screen, show locations of each on sketch.