

MISSISSIPPI DEPARTMENT OF ENVIRONMENTAL QUALITY
Bureau of Land and Water Resources

P. O. Box 10631
Jackson, MS 39289-0631
WATER WELL DRILLERS LOG

COUNTY WELL LOCATED
Jackson

WELL NUMBER CODED
296

DATE WELL COMPLETED
7-20-92

PERMIT NUMBER

NAME OF DRILLING FIRM
Coast Water Well Dr Inc.

NAME & MAILING ADDRESS OF LANDOWNER
Wayne Dethloff
Dethloff
Old Settlement Rd.
Moss Point, MS

WELL LOCATION: SEC TOWNSHIP RANGE
NW/NE 27 26 7 N 5 E

DISTANCE DIRECTION NEAREST TOWN
Miles of *Prichard*

OTHER LANDMARK

WELL PURPOSE Home Irrigation, Municipal, Industrial, Fish Pond, etc.

PUMP DATA

PUMP TYPE (Circle One):
Submersible, Turbine, Jet Flowing Well,
Other (Describe)

POWER TYPE (Circle One):
Electric, Tractor, Diesel, Gasoline, Butane,
Other (Describe) H/P 1

Pump Capacity (GPM) No. of Stages Setting Depth
10 *2* FT.

PUMP TEST
Well yielded _____ GPM with
a drawdown of _____ ft.
after _____ hours of pumping

WELL DATA

Well Depth <i>256'</i>	Casing Diameter (In.) <i>2"</i>	Casing Length (Ft.) <i>246'</i>
Type of Casing <i>PVC</i>	Hole Depth <i>256'</i>	Depth to Static Water Level <i>30'</i>

TYPE OF COMPLETION: (Circle One or More):
 Gravel Packed, Underreamed, Telescoped,
 Natural Development, Open Hole, Other

Top of Lap Pipe or Reduction in Casing
FEET IF TELESCOPED OR MORE THAN ONE SCREEN: USE BACK PAGE

LOG DATA

TYPE OF LOG RUN (Circle One):
Electric, Gamma Ray, Density, Sonic, No Log Run,
Other (Describe)

Name of Organization Running Log

SCREEN DATA

Diameter - Inches <i>2"</i>	Length - Feet <i>10'</i>	Slot Size - Inches <i>.008</i>
Screen Type <i>PVC</i>	Depth to Bottom - Feet <i>256'</i>	

GEOLOGIC DATA (Office Use Only)

Surface Elev.	Geologic Unit	Unit Thickness	Depth to Top
Subs. SWL	Date	Analysis	Aquifer Test

Driller's Remarks

DESCRIPTION OF FORMATIONS ENCOUNTERED	FROM	TO
<i>top soil</i>	<i>0</i>	<i>2</i>
<i>red clay</i>	<i>2</i>	<i>18</i>
<i>coarse sand/gravel</i>	<i>18</i>	<i>150</i>
<i>blue clay</i>	<i>150</i>	<i>185</i>
<i>med to coarse sand</i>	<i>185</i>	<i>256</i>

FORMATIONS / CORRECTIONS / TO

RECEIVED


OCT 07 1992

Dept. of Environmental Quality
Bureau of Land & Water Resources

IF MORE SPACE IS NEEDED, USE BACK

If well telescopes please sketch and show depths.

GROUND LEVEL

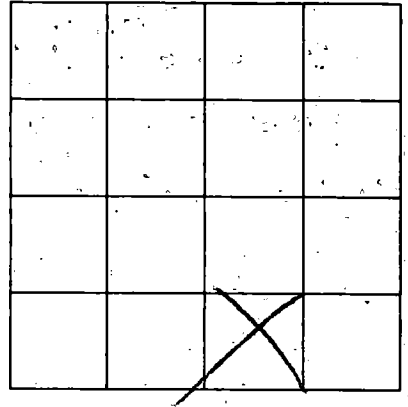

SECTION _____

Please indicate well location X.

ADDITIONAL INFORMATION

RECEIVED

U.S. DEPARTMENT OF THE INTERIOR
BUREAU OF LAND MANAGEMENT

If more than one screen,
show location of each on sketch.