

MISSISSIPPI DEPARTMENT OF ENVIRONMENTAL QUALITY
Office of Land and Water Resources

P. O. Box 10631
Jackson, MS 39289-0631
WATER WELL DRILLERS LOG

COUNTY WELL LOCATED JACKSON	
WELL NUMBER Q-2264	CODED
DATE WELL COMPLETED 10-25-01	

PERMIT NUMBER
NAME OF DRILLING FIRM Coast Water Well Service

NAME & MAILING ADDRESS OF LANDOWNER Bobby Delmas			
Old Airport Rd.			
Pascagoula Ms			
WELL LOCATION	SECTION	TOWNSHIP	RANGE
	4	8	5
DISTANCE	DIRECTION	NEAREST TOWN	
1 Miles	East	Pascagoula	
OTHER LANDMARK			
WELL PURPOSE: <input checked="" type="checkbox"/> Home, <input type="checkbox"/> Irrigation, <input type="checkbox"/> Municipal, <input type="checkbox"/> Industrial, <input type="checkbox"/> Fish Pond, etc.			

PUMP DATA		
PUMP TYPE (Circle One): Submersible, Turbine, <input checked="" type="radio"/> Jet, Flowing Well, Other (Describe) _____		
POWER TYPE (Circle One): <input checked="" type="radio"/> Electric, <input type="radio"/> Tractor, <input type="radio"/> Diesel, <input type="radio"/> Gasoline, <input type="radio"/> Butane, Other (Describe) _____ H/P 1		
Pump Capacity (GPM) 8.5	No. of Stages 2	Setting Depth _____ FT.
PUMP TEST		
Well yielded _____ GPM with a drawdown of _____ ft. after _____ hours of pumping		

WELL DATA		
Well Depth 256'	Casing Diameter (In.) 2"	Casing Length (ft.) 246'
Type of Casing PVC	Hole Depth 256'	Depth to Static Water Level 45'
TYPE OF COMPLETION: (Circle One or More): <input checked="" type="checkbox"/> Gravel Packed, <input type="checkbox"/> Underreamed, <input type="checkbox"/> Telescoped, <input checked="" type="checkbox"/> Natural Development, <input type="checkbox"/> Open Hole, <input type="checkbox"/> Other (Describe) _____		
WELL GROUTED TO A DEPTH OF 10 FEET Type Grout (circle one): Cement, <input checked="" type="checkbox"/> Bentonite, or Mix		

LOG DATA	
TYPE OF LOG RUN (Circle One): Electric, Gamma Ray, Density, Sonic, Neutron, Other (Describe) _____	
Name of Organization Running Log No Log Run	

SCREEN DATA		
Diameter - Inches 2"	Length - Feet 10'	Slot Size - Inches .008
Screen Type PVC	Depth to Bottom - Feet 256'	

GEOLOGIC DATA (Office Use Only)			
Surface Elev.	Geologic Unit	Unit Thickness	Depth to Top
Subs. SWL	Date	Analysis	Aquifer Test
Driller's Remarks			
Top of Lap Pipe or Reduction in Casing FEET IF TELESCOPED OR MORE THAN ONE SCREEN: USE BACK PAGE			

DESCRIPTION OF FORMATIONS ENCOUNTERED	FROM	TO	FORMATIONS (Continued)	FROM	TO
White + Orange Clay	0	1	Blue Clay	238	240
Marsh Mud	1	48	Gray coarse Sand	240	256
White coarse sand	48	84			
Marsh mud	84	101			
Fine white sand	101	107			
Gray clay	107	118			
Gray coarse sand	118	161			
Blue clay	161	180			
Gray medium sand	180	198			
Gray clay	198	225			
Gray coarse sand	225	238			

RECEIVED
SEP 21 2001

If well telescopes please sketch and show depths.


GROUND LEVEL

X			

SECTION 4

Please indicate well location X.

ADDITIONAL INFORMATION

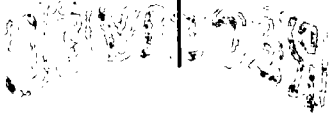

If more than one screen, show location of each on sketch.