

MISSISSIPPI DEPARTMENT OF ENVIRONMENTAL QUALITY

Office of Land and Water Resources

P. O. Box 10631
Jackson, MS 39289-0631
WATER WELL DRILLERS LOG

COUNTY WELL LOCATED
Jackson

WELL NUMBER Q- CODED

DATE WELL COMPLETED
11-13-01

PERMIT NUMBER

NAME OF DRILLING FIRM
Cost Water Well Service

NAME & MAILING ADDRESS OF LANDOWNER
Robert L. Jones
HATLEY Circle
MOSS POINT, MS

Latitude:
Longitude:

WELL LOCATION: SEC 23 TOWNSHIP 7 N RANGE 5 E

DISTANCE 4 Miles DIRECTION EAST of NEAREST TOWN MOSS POINT

OTHER LANDMARK

WELL PURPOSE: Home, Irrigation, Municipal, Industrial, Fish Pond, etc.

PUMP DATA

PUMP TYPE (Circle One):
Submersible, Turbine, Jet, Flowing Well, Other (Describe)

POWER TYPE (Circle One):
 Electric, Tractor, Diesel, Gasoline, Butane, Other (Describe) H/P

DESCRIPTION OF FORMATIONS ENCOUNTERED	FROM	TO
TOP SOIL	0	3
Yellow Red Blue Clay	3	12
Medium to coarse Sand w/ log	12	140
Blue Clay	140	165
Coarse Sand	165	205

WELL DATA

Well Depth 205' Casing Diameter (In.) 2" Casing Length (Ft.) 195'

Type of Casing PVC Hole Depth 205' Depth to Static Water Level 20'

TYPE OF COMPLETION: (Circle One or More):
Gravel Packed, Underreamed, Telescoped, Natural Development, Open Hole, Other (Describe)

WELL GROUTED TO A DEPTH OF 10 FEET
Type Grout (circle one): Cement, Bentonite, or Mix

SCREEN DATA

Diameter - Inches 2" Length - Feet 10' Slot Size - Inches .008

Screen Type PVC Depth to Bottom - Feet 205'

REC'D JAN 24 2002

Top of Lap Pipe or Reduction in Casing

FEET IF TELESCOPED OR MORE THAN ONE SCREEN: USE BACK PAGE

I certify that the well was drilled, constructed and completed in accordance with all applicable Requirements of the Mississippi Department of Environmental Quality and/or the Mississippi Department of Health regulations and state laws.


Jack Ritzel 472
Signature of Licensed Driller and License No.

12-28-01
Date

Additional Information Required On Back

If well telescopes please sketch and show depths.

GROUND LEVEL

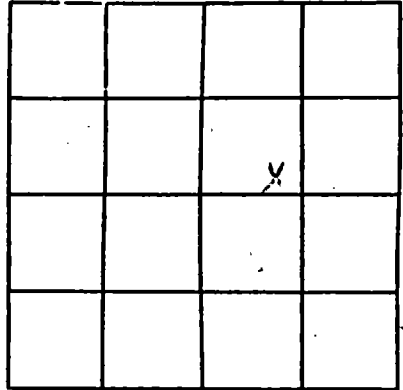

SECTION 23

Please indicate well location X.

Pump Capacity (GPM) <u>9</u>	No. of Stages <u>2</u>	Setting Depth FT.
---------------------------------	---------------------------	--------------------------

PUMP TEST

Well yielded _____ GPM with
a drawdown of _____ ft.
after _____ hours of pumping

LOG DATA

TYPE OF LOG RUN (Circle One): No Log Run.
 Electric, Gamma Ray, Density, Sonic, Neutron.
 Other (Describe) _____

Name of Organization Running Log _____

GEOLOGIC DATA (Office Use Only)

Surface Elev.	Geologic Unit	Unit Thickness	Depth to Top
Subs. SWL	Date	Analysis	Aquifer Test

Driller's Remarks

If more than one screen,
show location of each on sketch.