

Point Enter

MISSISSIPPI DEPARTMENT OF NATURAL RESOURCES
Bureau of Land and Water Resources

P.O. Box 10631

Jackson, Mississippi 39209

WATER WELL DRILLERS LOG

COUNTY WELL LOCATED
JACKSON

WELL NUMBER
DW1-DW8

CODED

DATE WELL COMPLETED
11-19-92 / 12-1-92

PERMIT NUMBER
0-532

NAME OF DRILLING FIRM
TET, INC.

NAME & MAILING ADDRESS OF LANDOWNER
CHEVRON USA

INDUSTRIAL RD

PASCAGOULA MS

WELL LOCATION: SEC 20 TOWNSHIP 8 RANGE 5

DISTANCE 1 Miles DIRECTION S of NEAREST TOWN MOSS POINT

OTHER LANDMARK

WELL PURPOSE: Home, Irrigation, Municipal, Industrial, Fish Pond, etc.
DEWATERING

PUMP DATA

PUMP TYPE (Circle One):
Submersible, Turbine, Jet, Flowing Well,
Other (Describe)

POWER TYPE (Circle One):
Electric, Tractor, Diesel, Gasoline, Butane,
Other (Describe) H/P

Pump Capacity (GPM) No. of Stages Setting Depth FT.

PUMP TEST

Well yielded _____ GPM with
a drawdown of _____ ft.
after _____ hours of pumping

WELL DATA

Well Depth **41.0'** Casing Diameter (In.) **4.0** Casing Length (Ft.) **33.5'**

Type of Casing **PUC** Hole Depth **41.0'** Depth to Static Water Level **4.0'**

TYPE OF COMPLETION: (Circle One or More):
Gravel Packed, Underreamed, Telescoped,
Natural Development, Open Hole, Other
(Describe) **SAND PACK**

Top of Lap Pipe or Reduction in Casing

FEET IF TELESCOPED OR MORE THAN ONE SCREEN: USE BACK PAGE

'LOG DATA

TYPE OF LOG RUN (Circle One):
Electric, Gamma Ray, Density, Sonic, Neutron,
Other (Describe) No Log Run

Name of Organization Running Log

SCREEN DATA

Diameter - inches **4.0** Length - Feet **7.5'** Slot Size - inches **.010**

Screen Type **SLOTTED PUC** Depth to Bottom - Feet **41.0**

GEOLOGIC DATA (Office Use Only)

Surface Elev.	Geologic Unit	Unit Thickness	Depth to Top
Subs. SWL	Date	Analysis	Aquifer Test

Driller's Remarks

RECEIVED

DEC 10 1992

**Dept. of Environmental Quality
Bureau of Land & Water Resources**

DESCRIPTION OF FORMATIONS ENCOUNTERED	FROM	TO	FORMATION (continued)	FROM	TO
NOT RECORDED					

IF MORE SPACE IS NEEDED, USE BACK

If well telescopes please sketch and show depths.


GROUND LEVEL

		X	

SECTION 20

Please indicate well location X.

ADDITIONAL INFORMATION

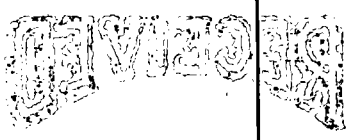

If more than one screen,
show location of each on sketch.