

B3

WATER WELL DRILLERS LOG

2-15-62

Date: 2-15, 1962, Driller: U. L. Welch County Jasper

(1) Owner of Land: J. T. Weir  
 (Name)  
Garlandville Miss  
 (Address)

(2) Location: NE 1/4, SE 1/4, Sec. 1 T. 4 R. 11  
10 miles SE of Newton  
 (distance) (direction) (Nearest Town)

(3) Topography:  (Hilly)  (Flat)  (Level)

(4) Purpose of Well: Domestic  
 (Domestic Irrigation, Municipal, Industrial, Other)

Description & Color of Materials Sand, Clay, Red Clay, Shell, etc.	Thick- ness Feet	Depth Feet
Red clay	32	0-32
Yellow sand	68	32-100
White sand	40	100-140

Information upon completion of well:

(1) Diameter 3 1/2 inches.

(2) Total Depth 140 feet.

(3) Water Level 36 feet below top of ground.

(4) Cased to 139, Size 2"


(5) Screen: Size 2", Length 10'

(6) Were any formations sealed against pollution?  
 yes,  no,

If YES depth of formation \_\_\_\_\_

Why \_\_\_\_\_

Drillers Remarks: \_\_\_\_\_

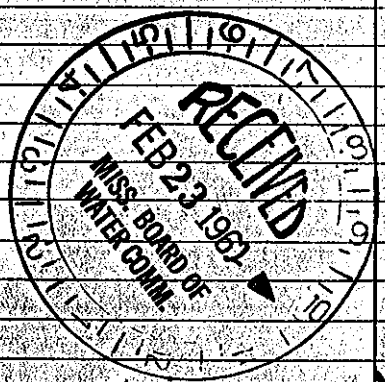

29 Well No.

(Use Back Side)

Retain this copy for your office files.